


T. 3S. R. 1W. W.M.

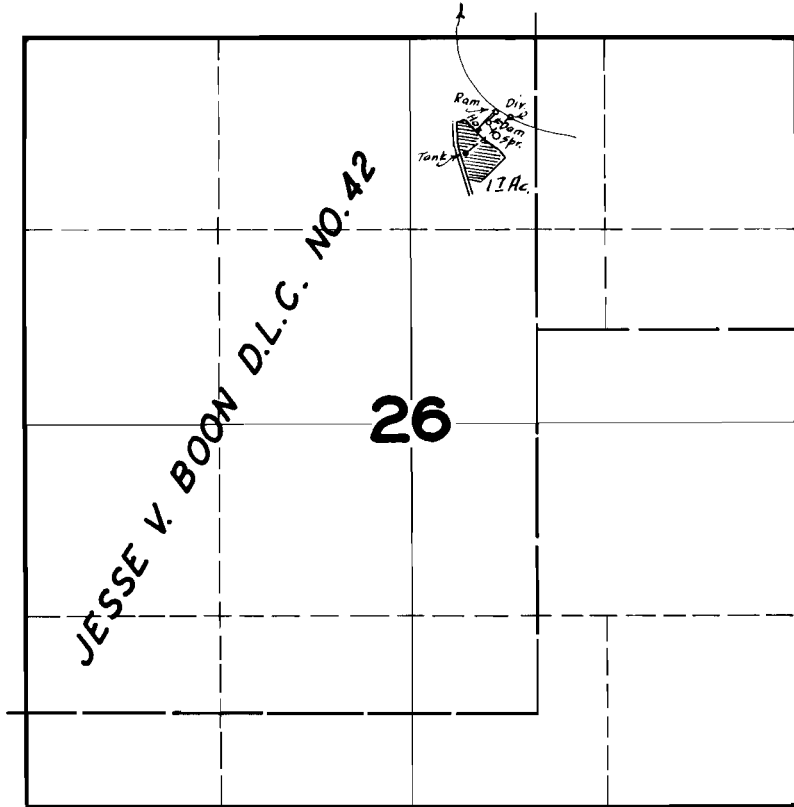

FINAL PROOF SURVEY UNDER

Application No. 16428 Permit No. 12228

IN NAME OF

LOUIS R. & LOUISE W. TOON

Surveyed JUNE 10 1947, by JAS. E. BUNNELL