


T.12S.R.4W.W.M.

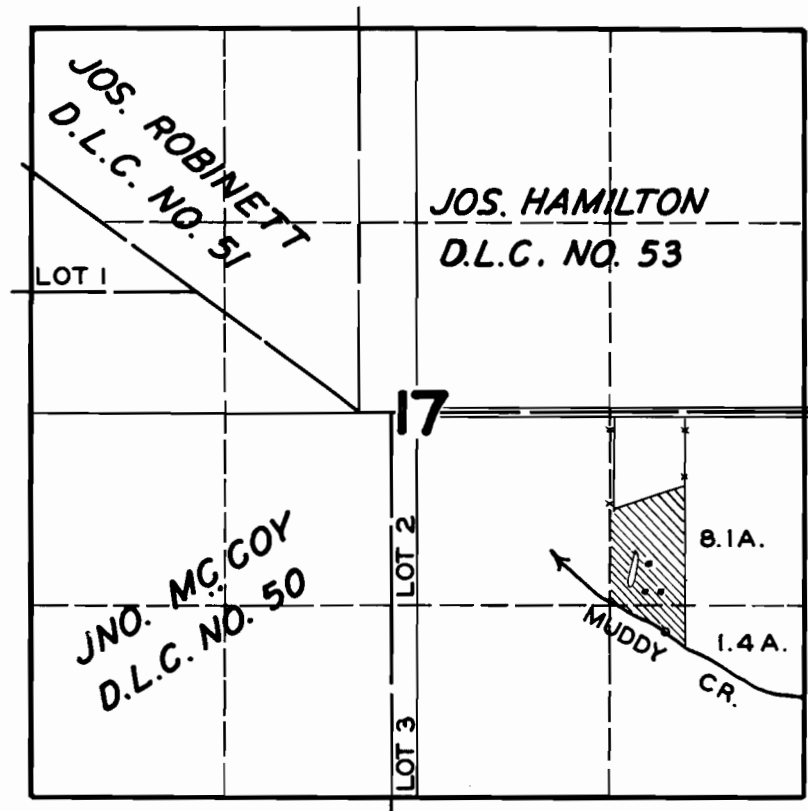

FINAL PROOF SURVEY
UNDER

Application No. **16930** Permit No. **12684**
IN NAME OF

MR. & MRS. W.E. RASMUSSEN

Surveyed **MAY 11, 1948**, by **JAS. E. BUNNELL**