


T. 2 S. R. 3 W. W. M.

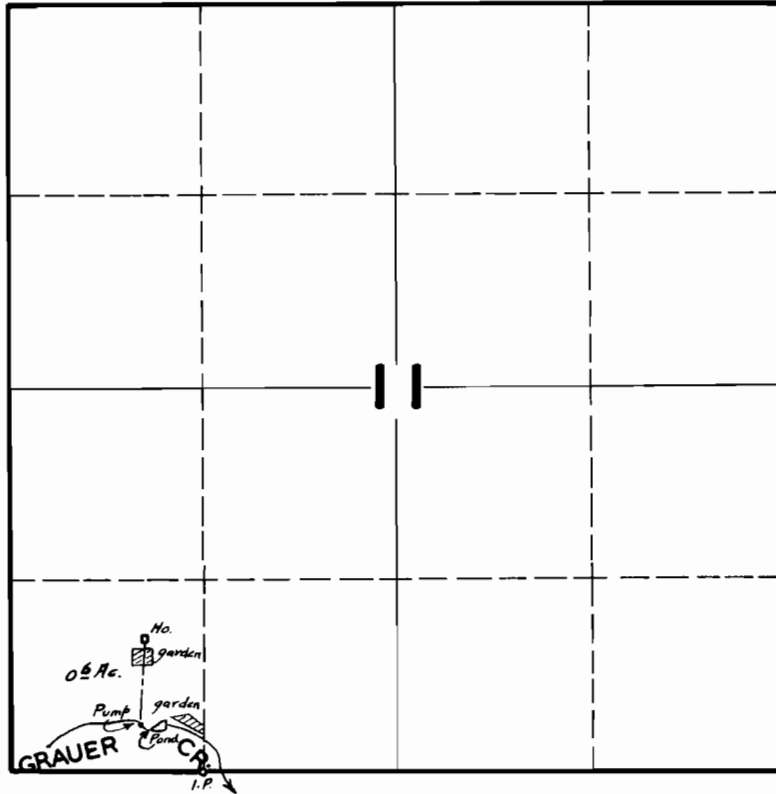

FINAL PROOF SURVEY
UNDER

Application No. **17014** Permit No. **12760**
IN NAME OF

RALPH F. O'ROURKE

Surveyed **JULY 17, 1947**, by **JAS. E. BUNNELL**