


T.2S.R.2W.W.M.

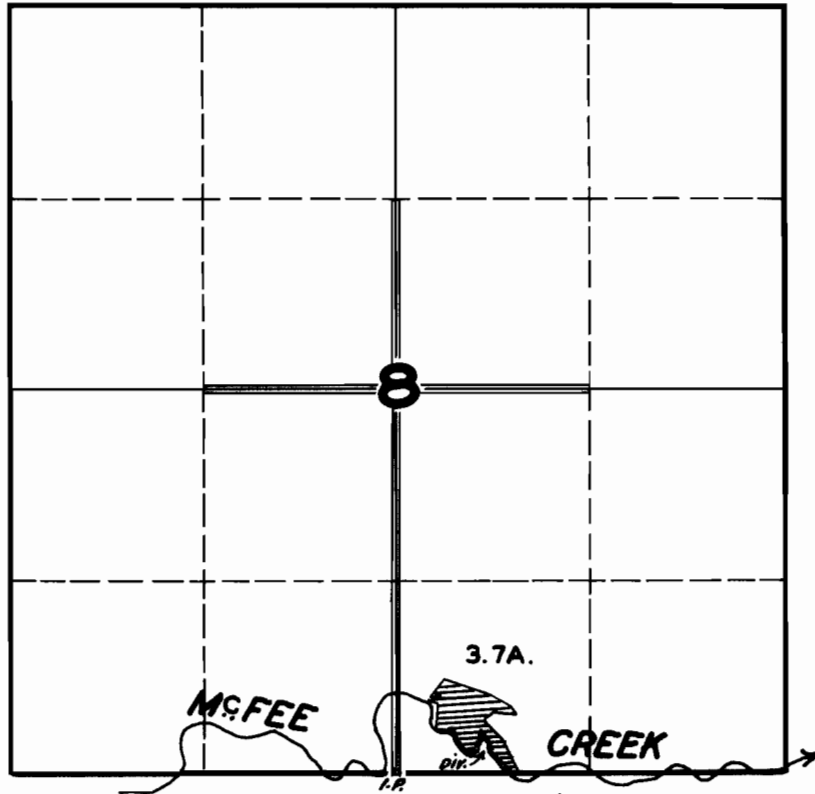

FINAL PROOF SURVEY
UNDER

Application No. 17079 Permit No. 12810
IN NAME OF

ARTHUR F. LINDEN

Surveyed MAY 17 1948, by JAS. E. BUNNELL