


T.10S.R.6W.W.M.

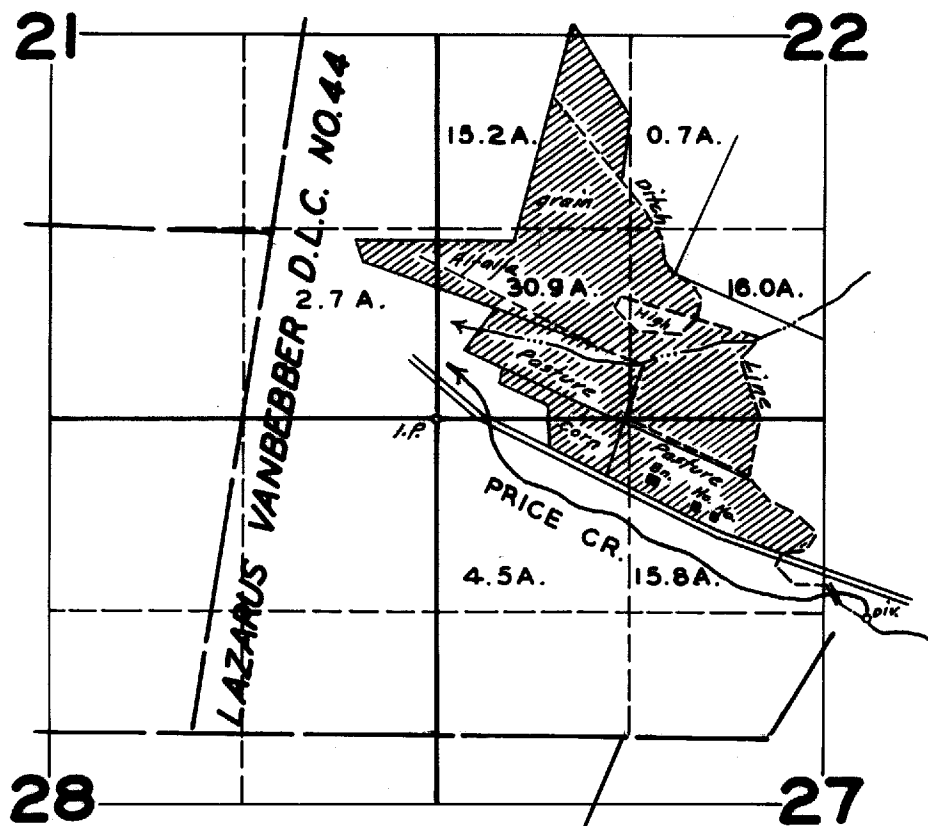

FINAL PROOF SURVEY

UNDER

Application No. 17110..... Permit No. 12907..

IN NAME OF

FARREN & YVONNE F. NELSON

Surveyed **SEPT. 21 1948**, by **JAS. E. BUNNELL**