


T.9S.R.2E.W.M.

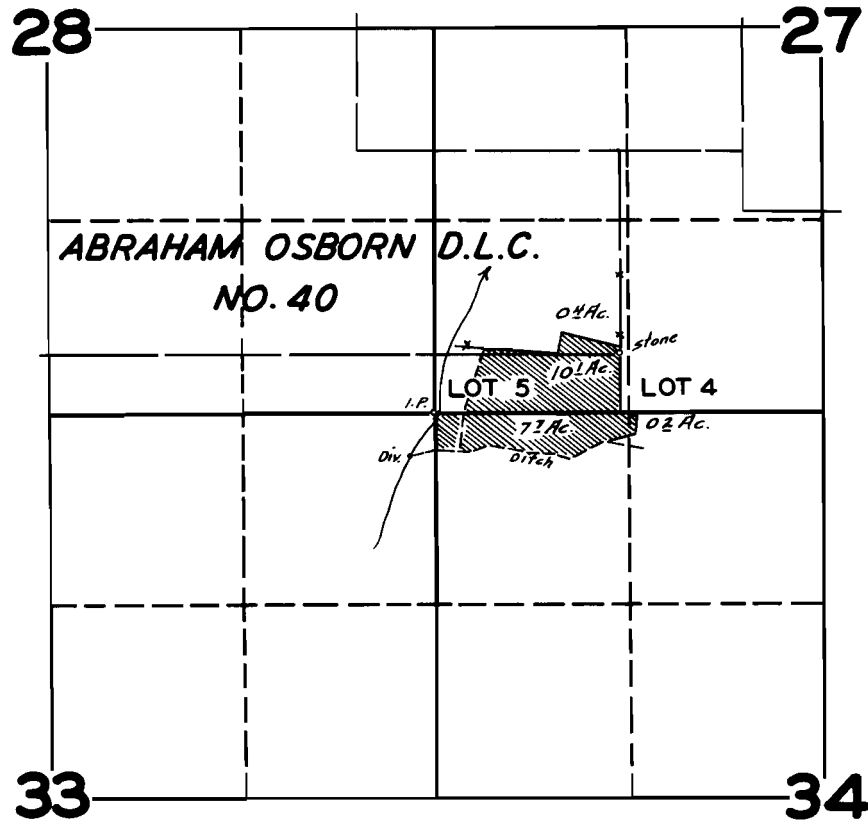

FINAL PROOF SURVEY

UNDER

Application No. 17612 Permit No. 13302

IN NAME OF

LAURANCE A. WALWORTH

~~Survived OCT. 13 1947, by JAS. E. BUNNELL~~