


# T.4S.R.4W.W.M.

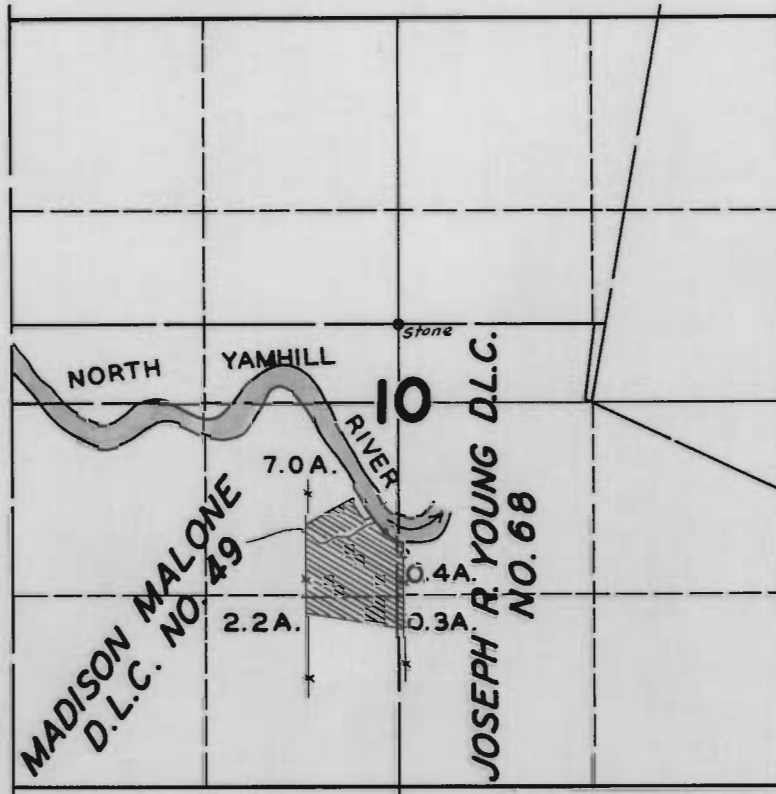

## FINAL PROOF SURVEY UNDER

Application No. 17757 Permit No. 13448

IN NAME OF

C. O. DENNIS

Surveyed APR. 3 1947, by JAS. E. BUNNELL