


T. 4 S. R. 1 W. W. M.

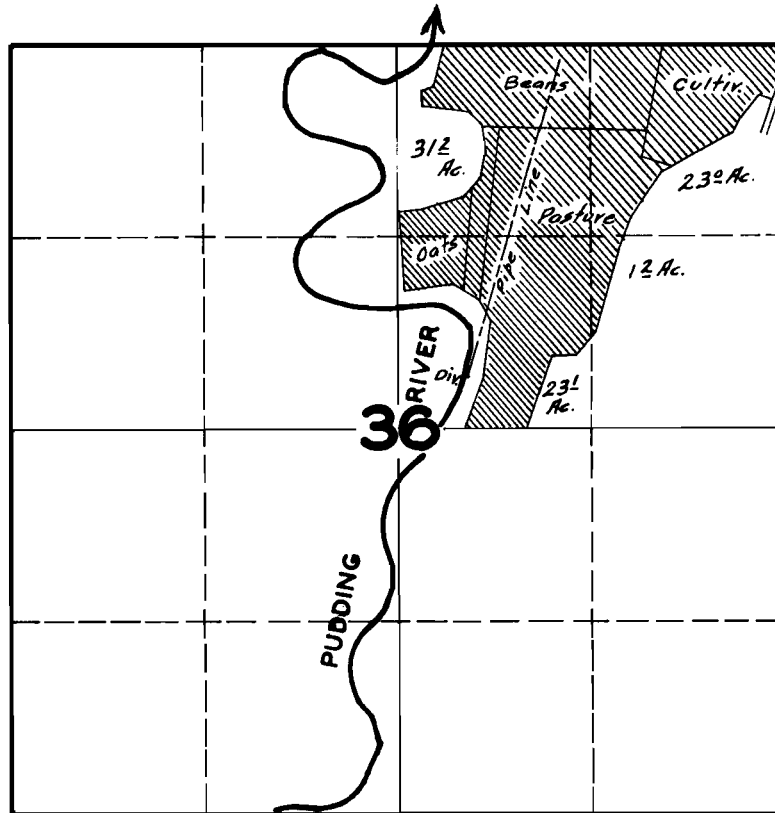

FINAL PROOF SURVEY
UNDER

Application No. 17875 Permit No. 13550

IN NAME OF

FLOYD LENHARDT

Surveyed JUN. 12. 1947, by JAS. E. BUNNELL