


T.28S.R.12&13W.W.M.

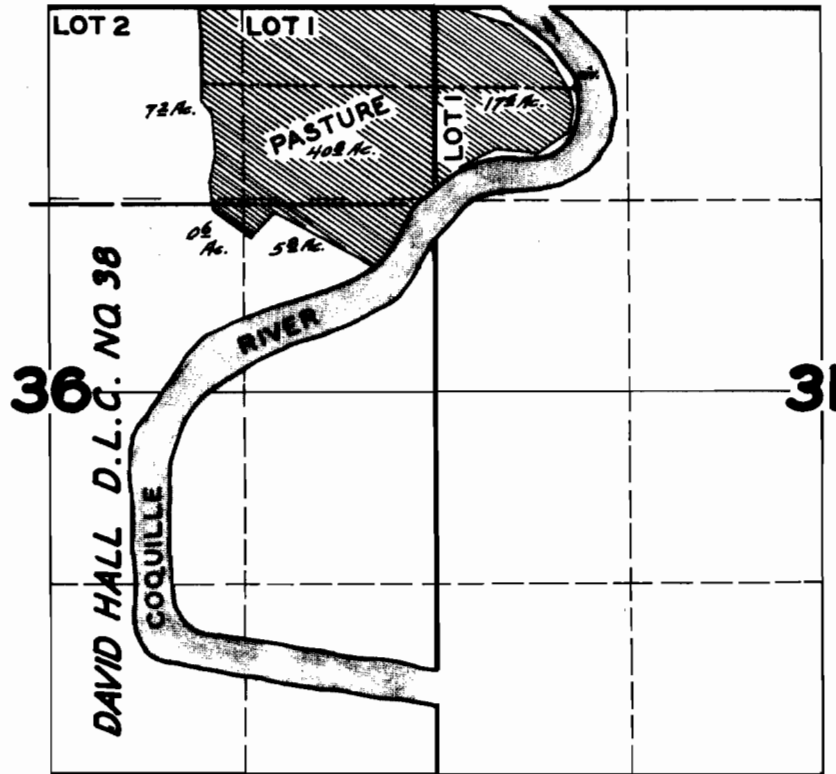

**FINAL PROOF SURVEY
UNDER**

Application No. 17993 Permit No. 13667

IN NAME OF

FRANK BURBANK

Surveyed JUL. 25 1947, by JAS. E. BUNNELL