


T.3S.R.4W.W.M.

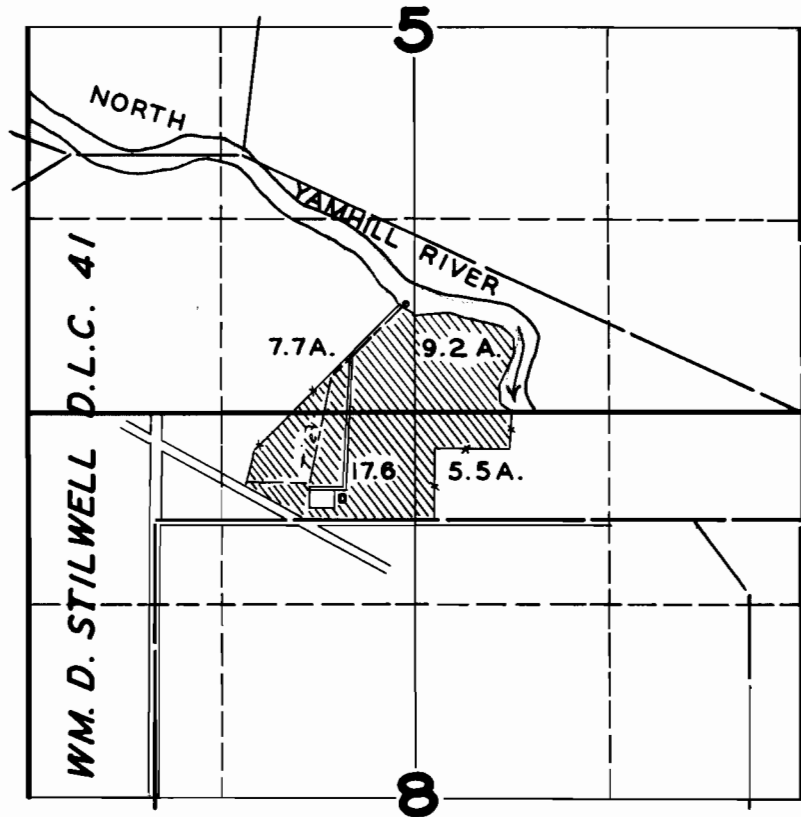

FINAL PROOF SURVEY

UNDER

17 592

13 288

Application No. 18 229 Permit No. 13 890

IN NAME OF

FRANK M. TRIVELPIECE

Surveyed APR. 3 1947, by JAS. E. BUNNELL