


T. 26 S. R. 3 W. W.M.

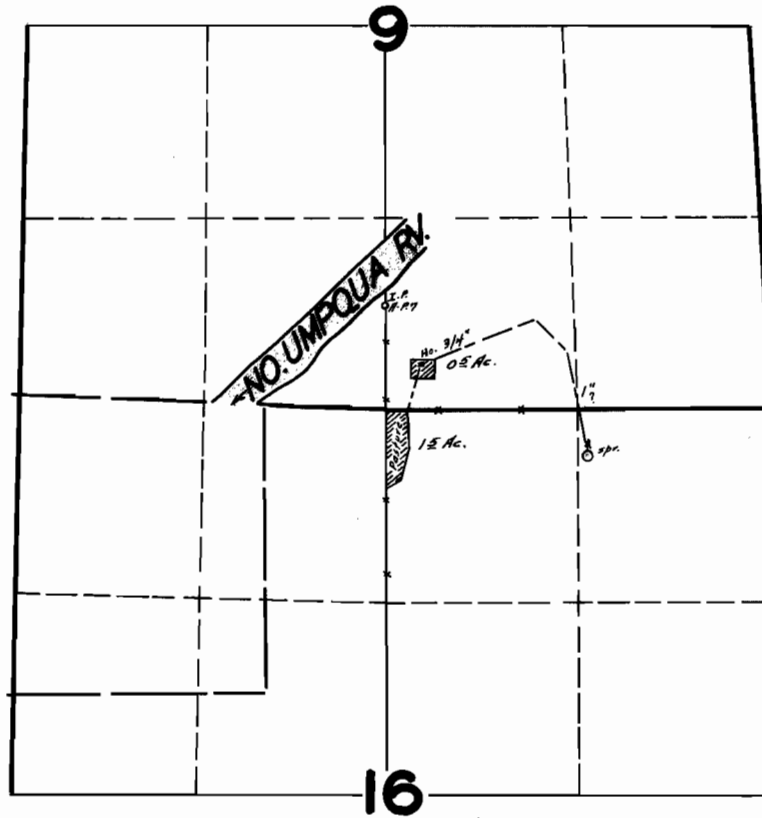

FINAL PROOF SURVEY UNDER

Application No. 18562 Permit No. 14218

IN NAME OF
MRS. H.E. WOOD

Surveyed JULY 10, 1945 by J. B. Russell