


T.IIS. R.IIW.W.M.

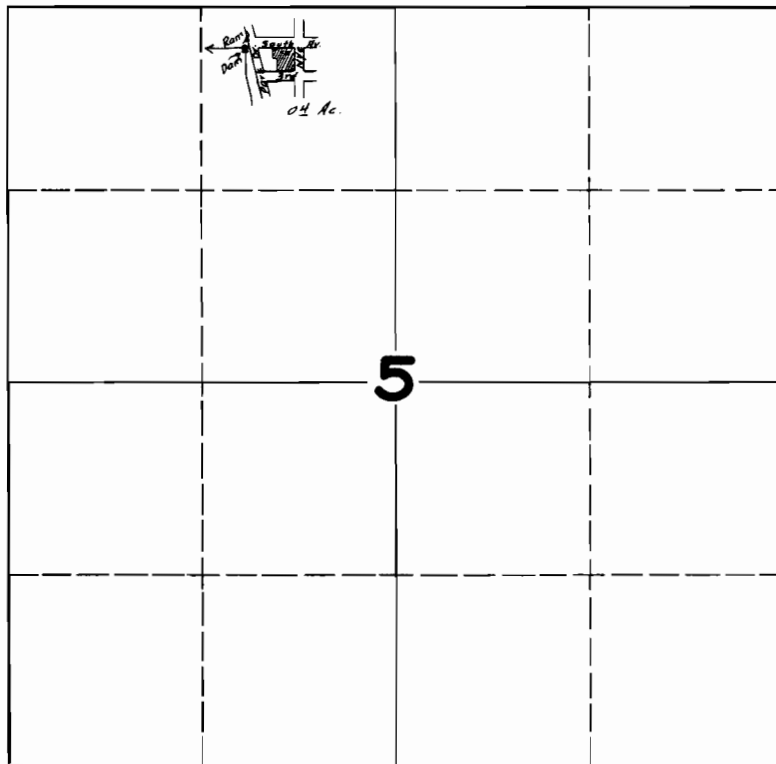

FINAL PROOF SURVEY

UNDER

Application No. 18651 Permit No. 14283

IN NAME OF

L. LEONARD KRAUSE

Surveyed AUG. 22, 1945, by

[Handwritten signature]