


T. 27 S., R. 13 W. W.M.

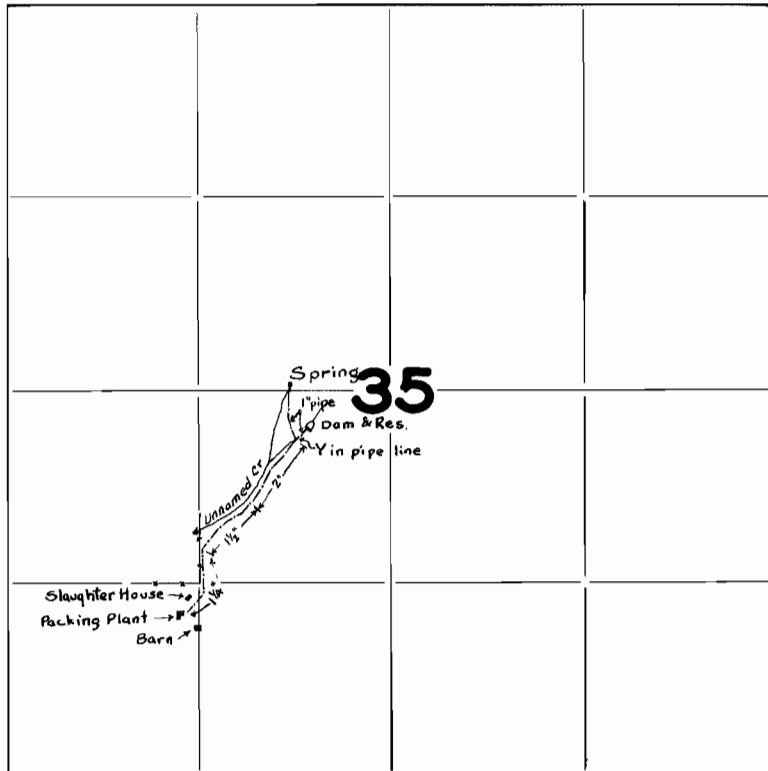

FINAL PROOF SURVEY
UNDER

Application No. 18701 Permit No. 14326

IN NAME OF

Lee Stonecypher

Surveyed Aug. 24 1943, by Geo. O. Naderman