


T.16S.R.2E.W.M.

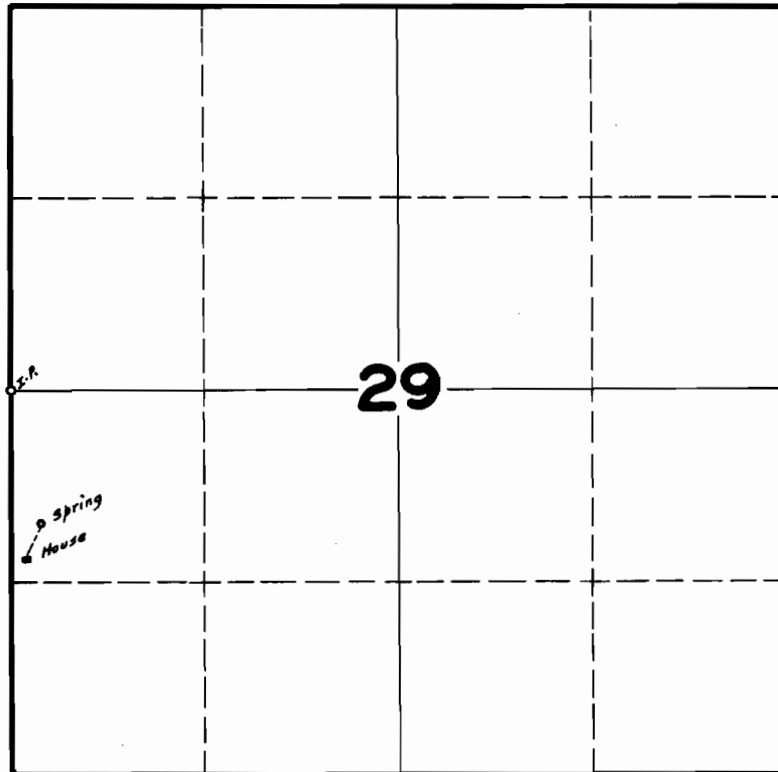

**FINAL PROOF SURVEY
UNDER**

Application No. 18764 Permit No. 14414

IN NAME OF

GUY O. JONES

Surveyed JULY 29 1946 by [Signature]