T.5S. R.1W.W.M.

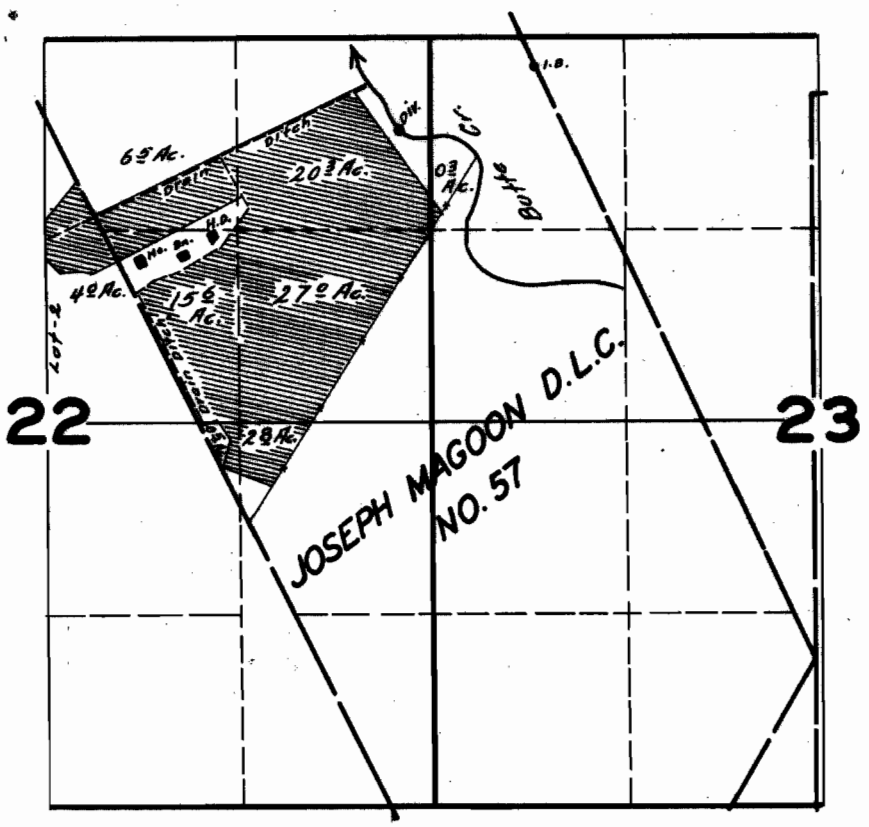

FINAL PROOF SURVEY

UNDER

Application No. 18802 Permit No. 14443

IN NAME OF

JOSEPH & ADELA SEBRES

Surveyed APR. 1 1946, by [signature]

1946-A