


T.4S.R.2E.W.M.

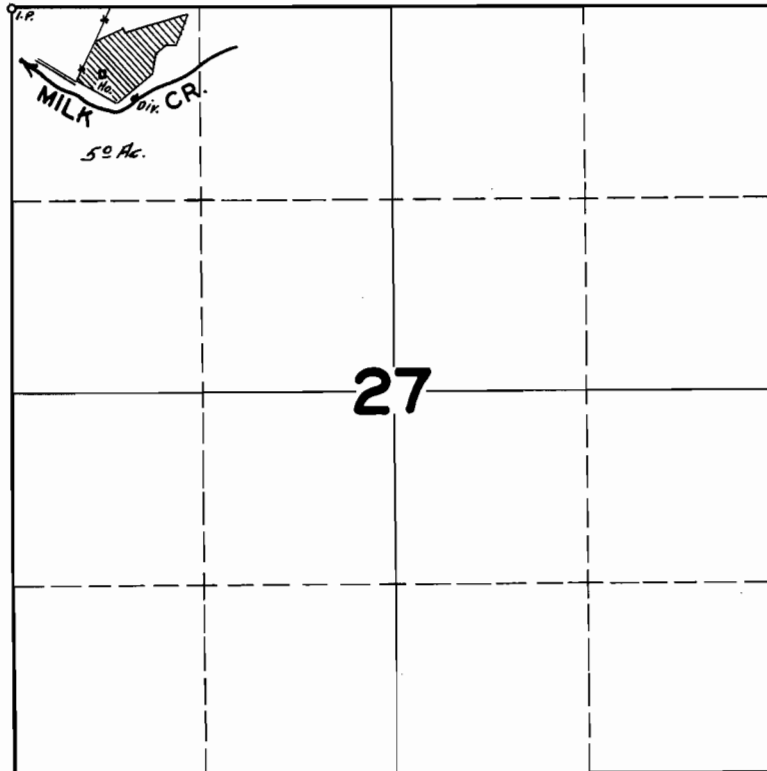

**FINAL PROOF SURVEY
UNDER**

Application No. 18813 Permit No. 14453

IN NAME OF

ARVO KRIVONEN

Surveyed JUN. 13 1947, by JAS. E. BUNNELL