


T.6S.R.1W.W.M.

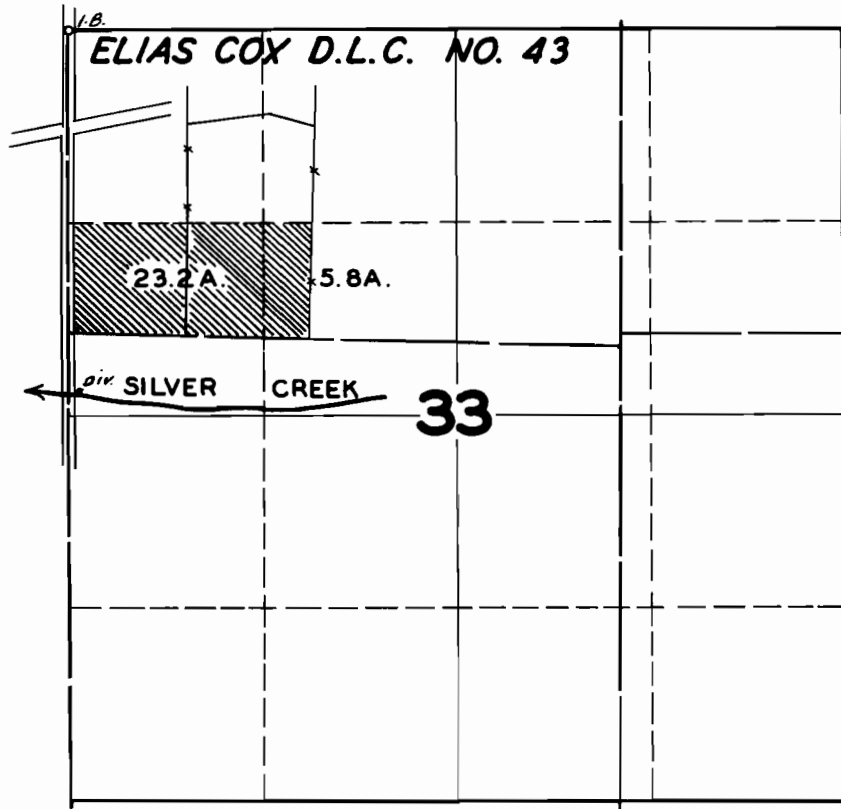

FINAL PROOF SURVEY UNDER

Application No. 18859 Permit No. 14492

IN NAME OF

ALBERT G. MIKKELSON

Surveyed SEP. 11 1947, by JAS. E. BUNNELL