


# T. 10 S. R. 1 W. W. M.

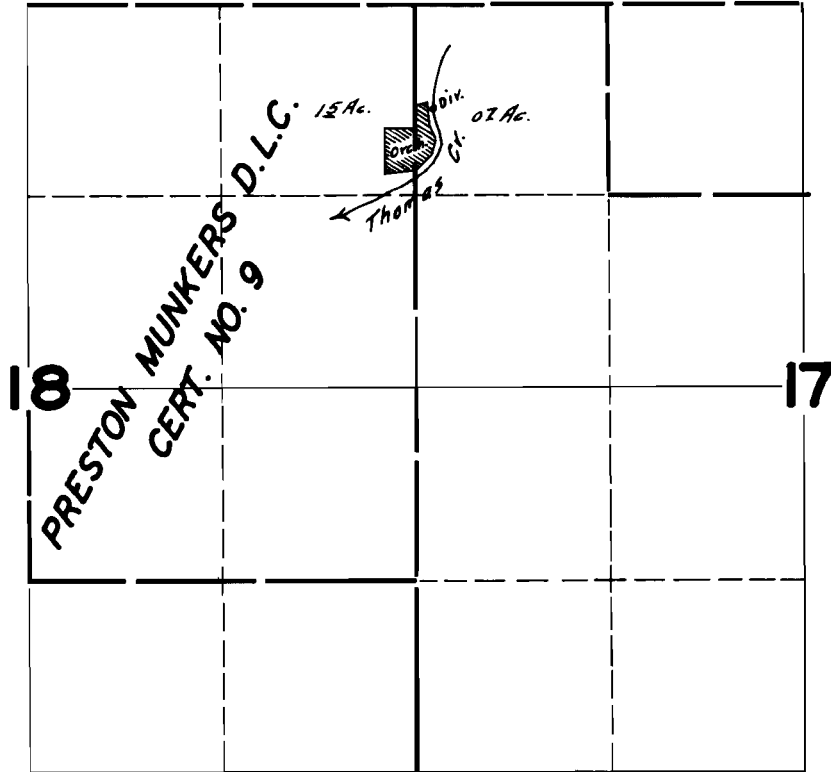

## FINAL PROOF SURVEY UNDER

Application No. 18908 Permit No. 14520

IN NAME OF  
H. E. WINTER

Surveyed MAY 14 1946, by [Signature]