


T. 7S. R. 3E. W. M.

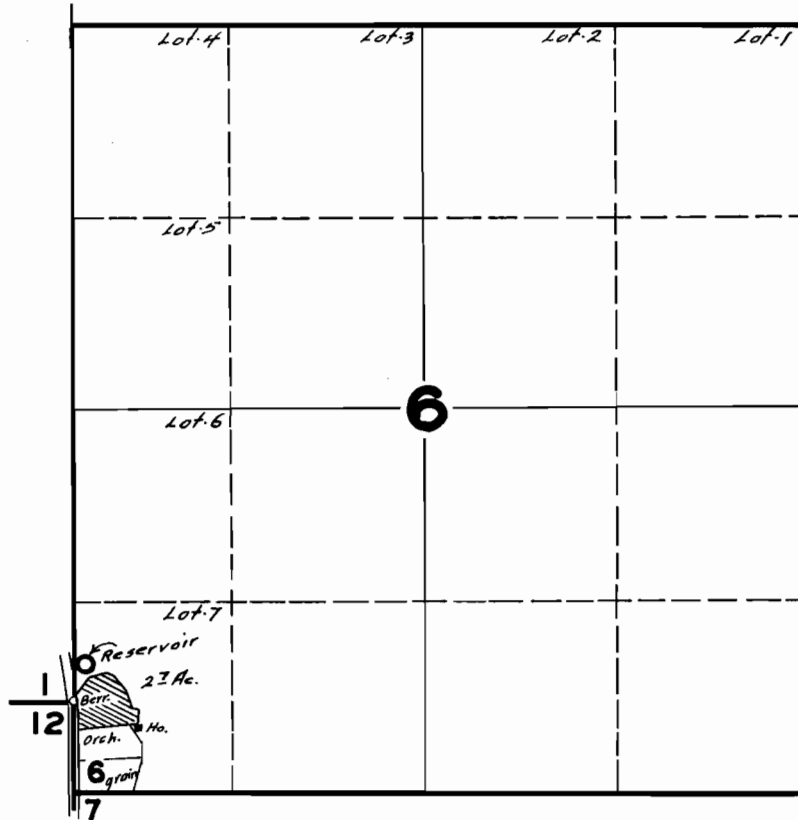

FINAL PROOF SURVEY

UNDER

R-18918 R-753
Application No. 18919 Permit No. 14529

IN NAME OF

JOHN R. GARDINER & ANNIE M. GARDINER

Surveyed AUG. 15 1946 by

[Signature]