


T.7S.R.IW.W.M.

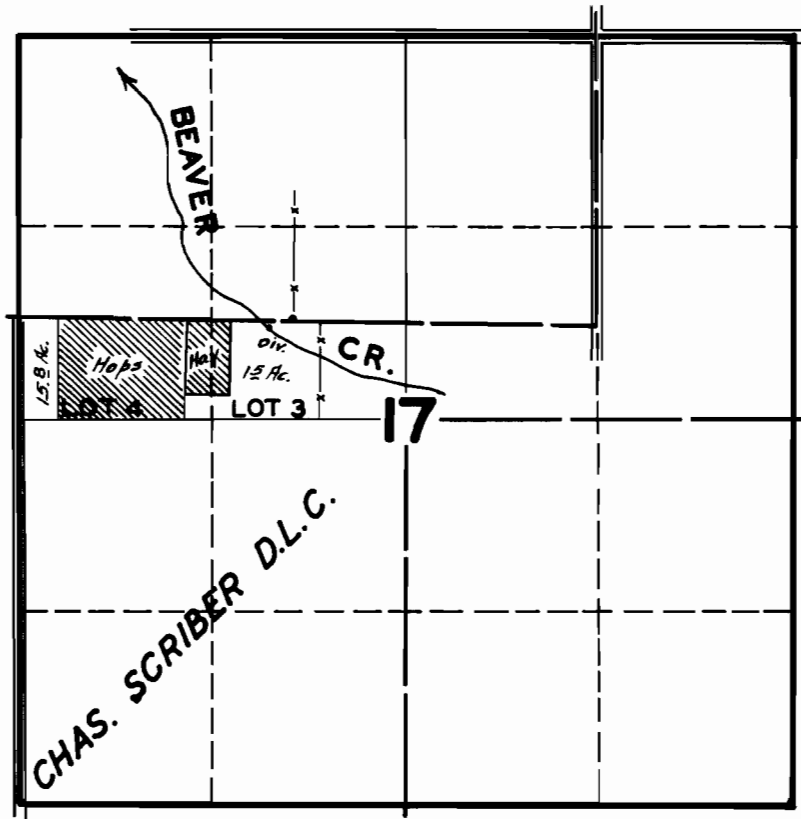

FINAL PROOF SURVEY UNDER

Application No. 18927 Permit No. 14536

IN NAME OF

PAUL STAEDLI

Surveyed JUN. 24 1947, by JAS. E. BUNNELL