


# T.9S.R.1E.W.M.

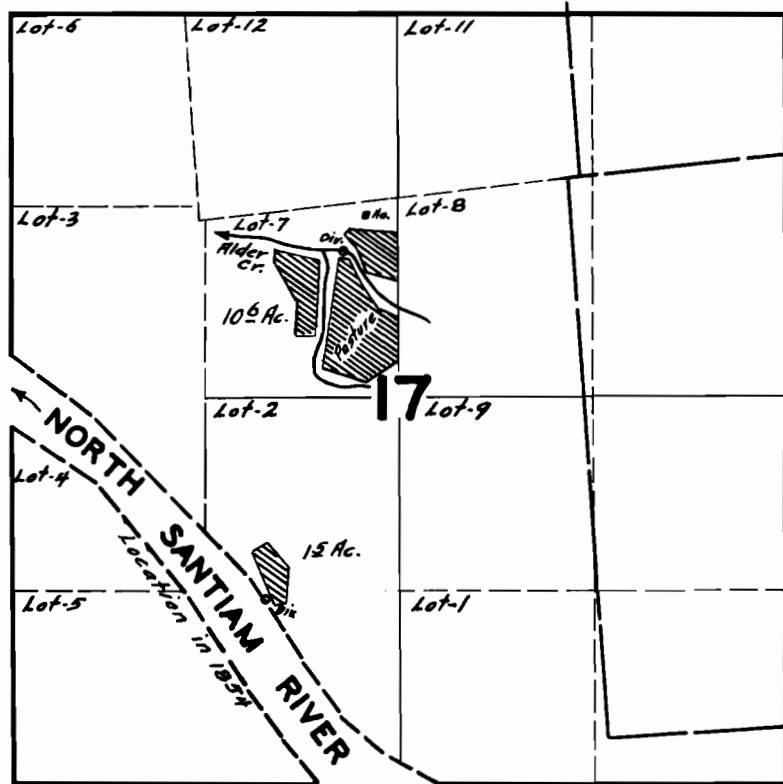

## FINAL PROOF SURVEY

UNDER

Application No. 18928 Permit No. 14537

IN NAME OF

ALFRED POOLE

Surveyed APR. 6 1946, by

*[Handwritten Signature]*