


# T. 2S. R. 1E. W. M.

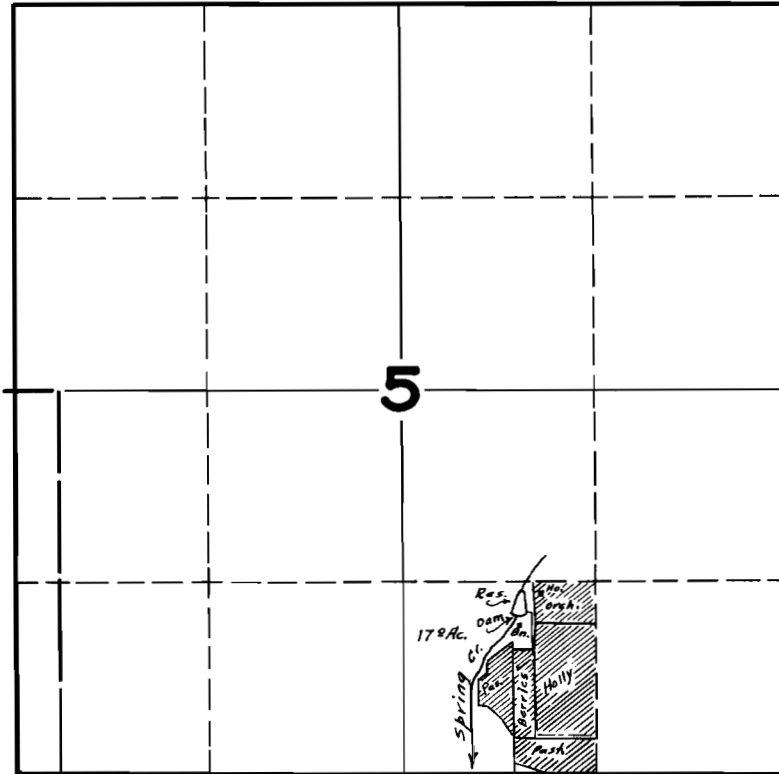

## FINAL PROOF SURVEY

R-20464 UNDER  
20465

R-800  
15977

Application No. 19011 Permit No. 14700

IN NAME OF

A. W. RHODES

Surveyed JUNE 17 1946, by

*J. M. Sumrell*