


T.21S.R.2W.W.M.

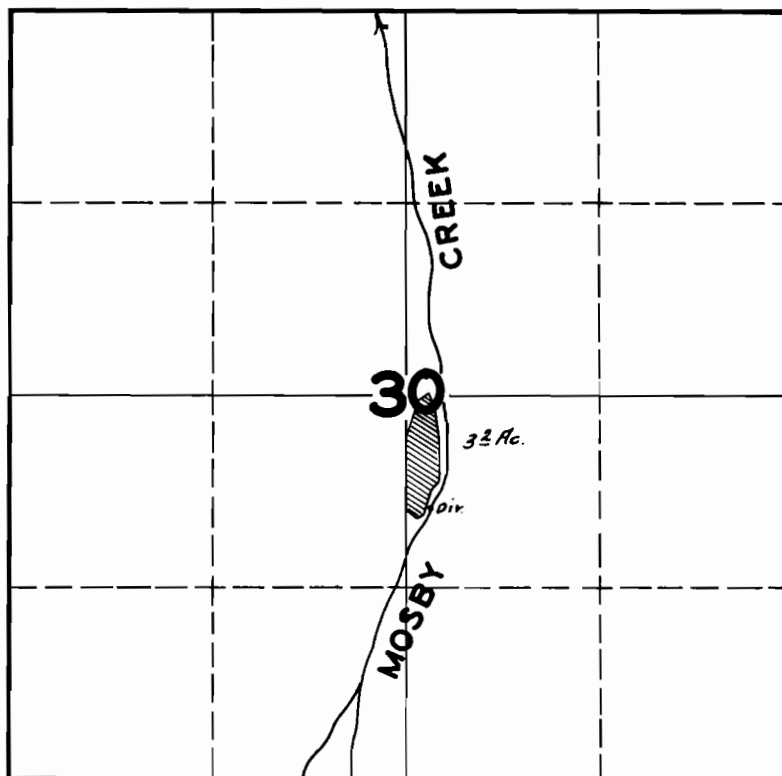

**FINAL PROOF SURVEY
UNDER**

Application No. 19166 Permit No. 14764

IN NAME OF

HENRY C. & NORA BOSTICK

Surveyed AUG. 6 1947, by JAS. E. BUNNELL