


T.1S. R.2W.W.M.

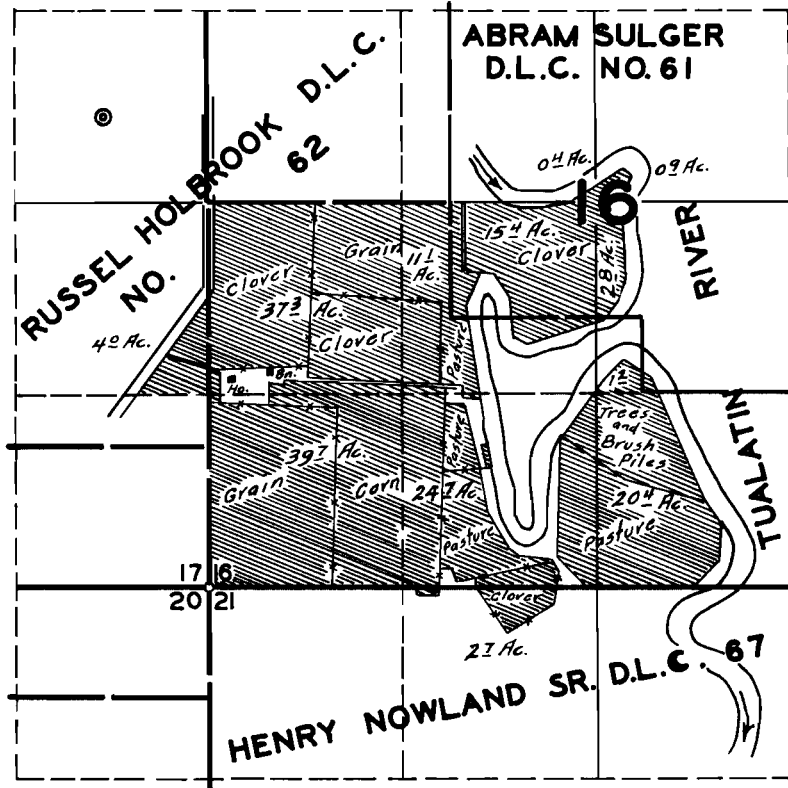

FINAL PROOF SURVEY UNDER

Application No. 19181 Permit No. 14778

IN NAME OF

ALBERT C. GREENER

Surveyed AUG. 2, 1944, by