


T.3S.R.10W.W.M.

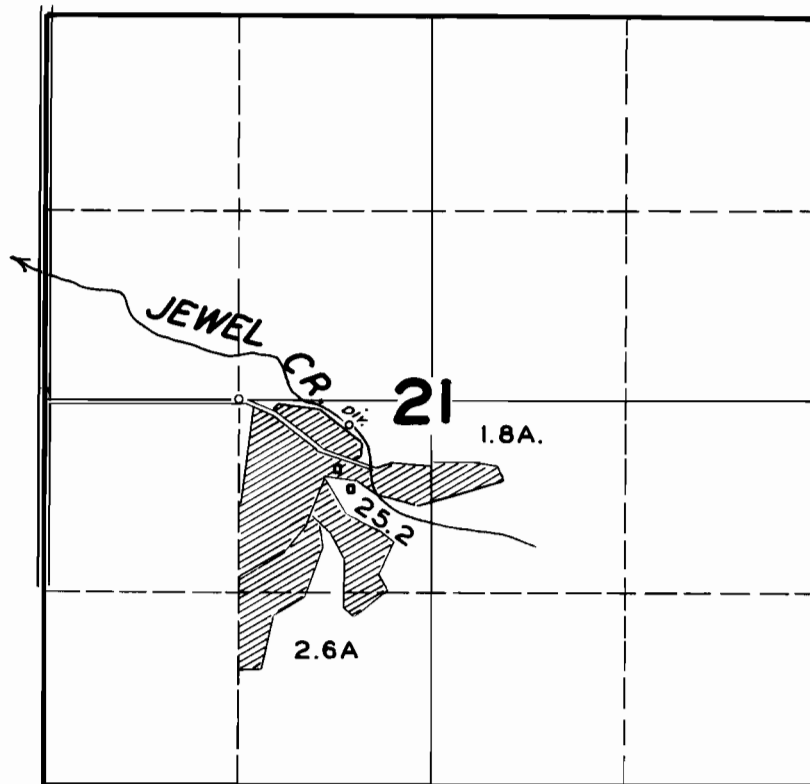

FINAL PROOF SURVEY
UNDER

Application No. **19210** Permit No. **14803**
IN NAME OF

HAROLD GUTHERT

Surveyed **AUG. 31, 1948**, by **JAS. E. BUNNELL**