


T.8S.R.4W.W.M.

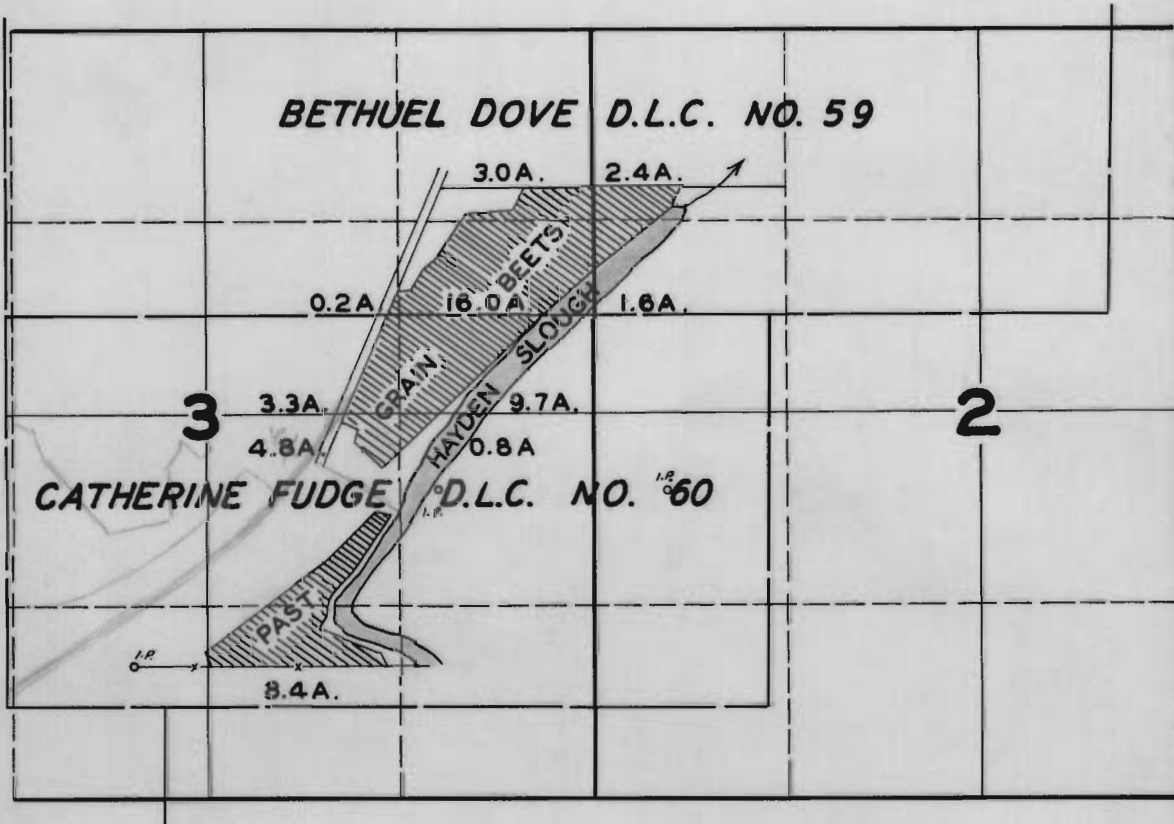

FINAL PROOF SURVEY

UNDER

Application No. 19221 Permit No. 14811

IN NAME OF

CHARLES A. EVANS

Surveyed OCT. 3, 1947, by JAS. E. BUNNELL