


T.4S.R.1W.W.M.

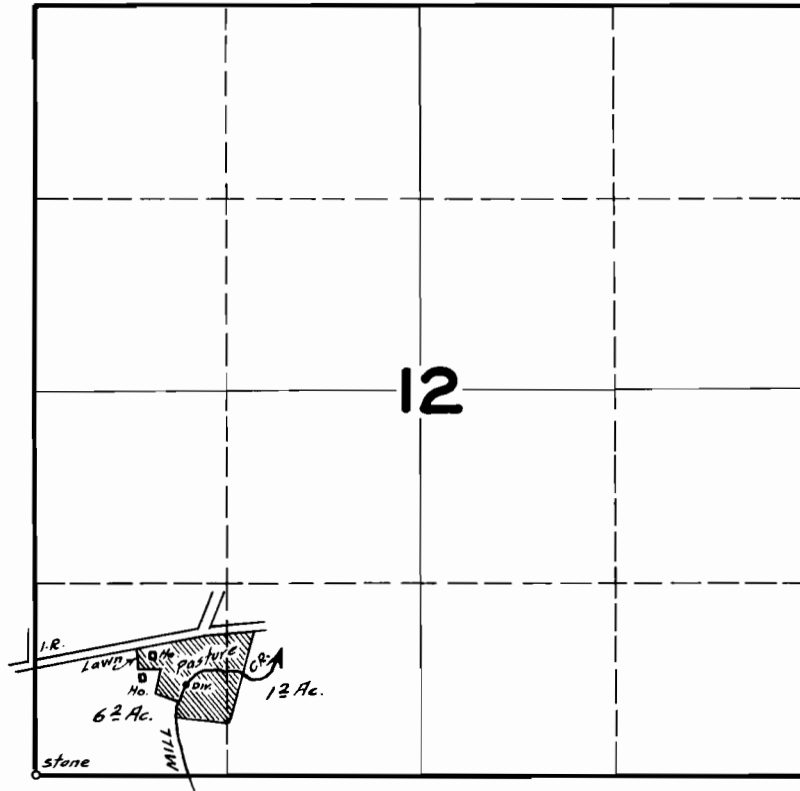

FINAL PROOF SURVEY

UNDER

Application No. 19229 Permit No. 14816

IN NAME OF

JONAS M. WILL & GUSSIE M. WILL

Surveyed APR. 16 1947, by JAS. E. BUNNELL