


T.9S.R.45E.W.M.

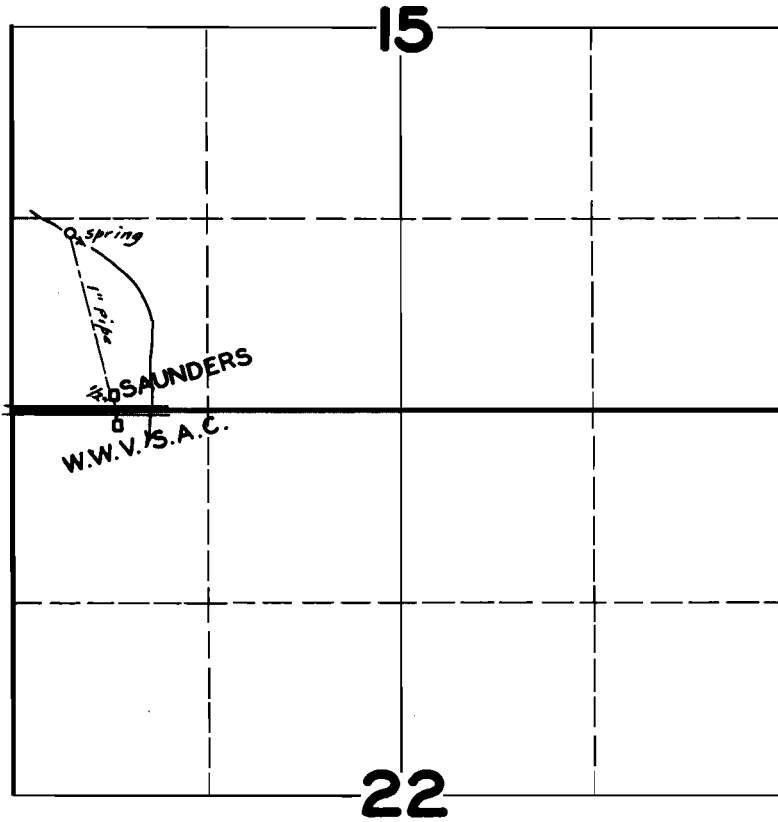

FINAL PROOF SURVEY
UNDER

Application No. 19308 Permit No. 14893

IN NAME OF

WORLD WAR VETERANS STATE AID COMMISSION & MERRITT W. SAUNDERS

Surveyed SEP. 28 1946. *[Signature]*