


T.29S.R.12W.W.M.

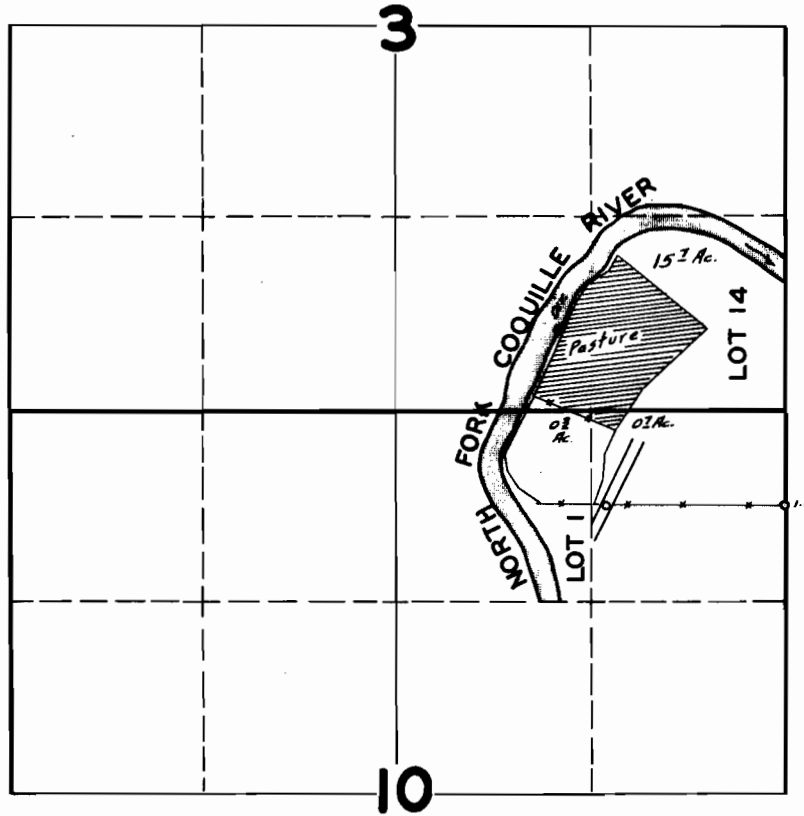

**FINAL PROOF SURVEY
UNDER**

Application No. 1940.4... Permit No. 14975

IN NAME OF

WM. C. STEVENS

Surveyed AUG. 20 1947, by JAS. E. BUNNELL