


# T. 15. R. 4 W. W. M.

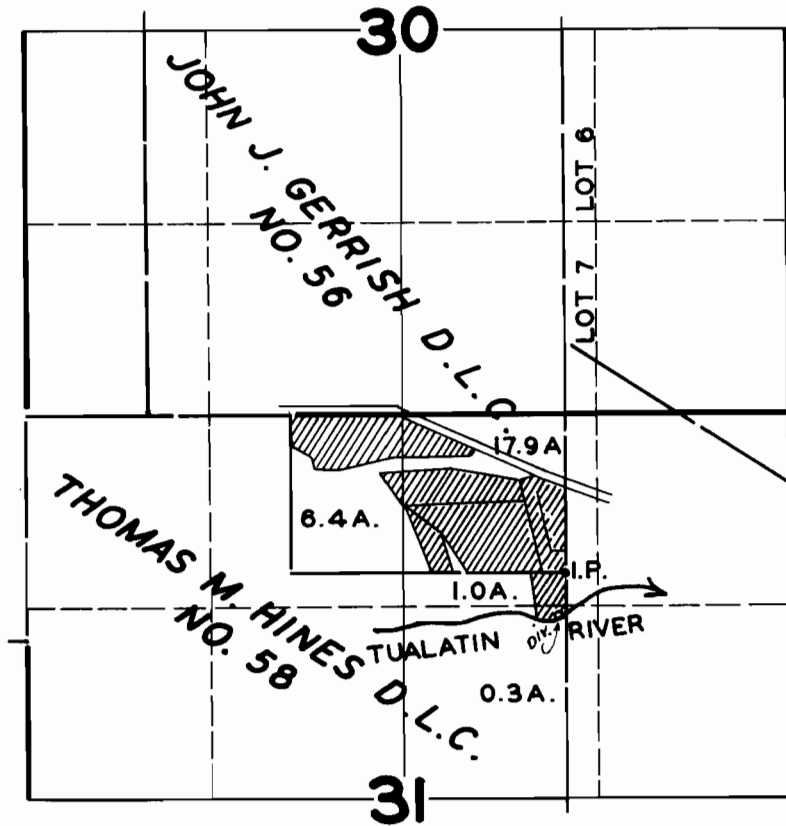

## FINAL PROOF SURVEY UNDER

Application No. 19441... Permit No. 15038...  
IN NAME OF

R. F. CLARKE

Surveyed JULY 2, 1947, by JAS. E. BUNNELL