


T.17S.R.1W.W.M.

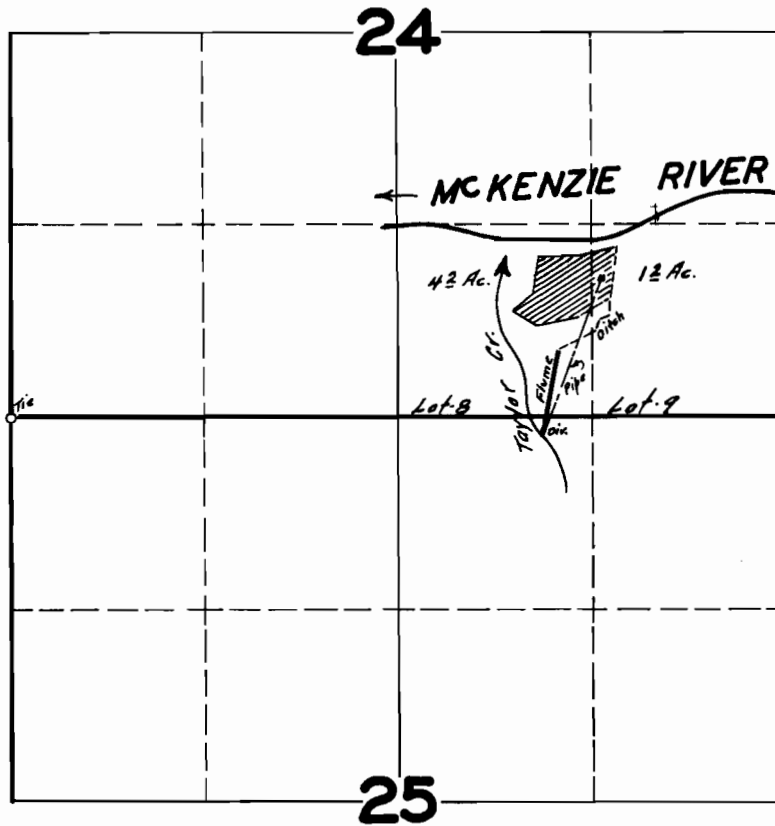

FINAL PROOF SURVEY
UNDER

Application No. 19478 Permit No. 15060

IN NAME OF

M. S. PAGE

Surveyed JULY 31, 1946, by [Signature]