


T.41S.R.12W.W.M.

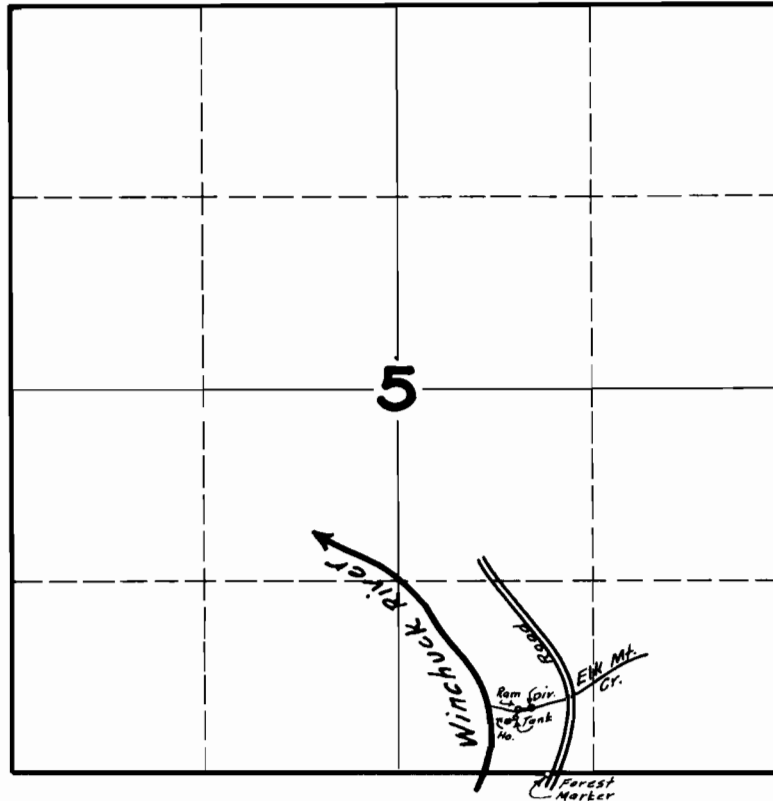

**FINAL PROOF SURVEY  
UNDER**

**Application No. 19487 Permit No. 15067**

**IN NAME OF  
W.H. BRULE**

**Surveyed JUL. 21, 1947, by JAS. E. BUNNELL**