


**T.2S.R.2W.W.M.**

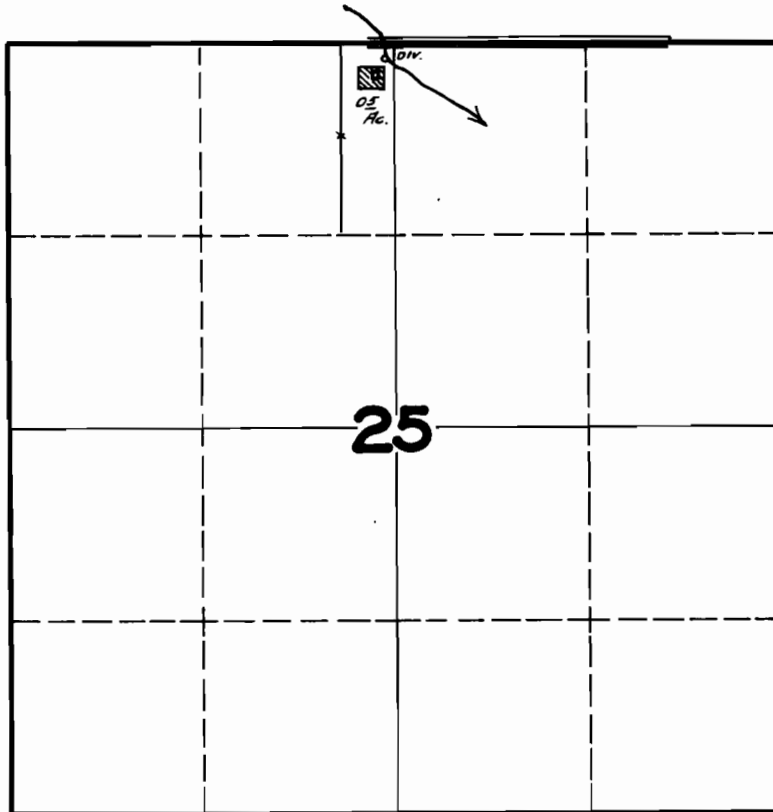

**FINAL PROOF SURVEY**  
UNDER

Application No. **19488** Permit No. **15068**  
IN NAME OF

**ELMONT E. ROCKWELL**

Surveyed **OCT. 22. 1947.** by **JAS. E. BUNNELL**