


T.11S.R.31E.W.M.

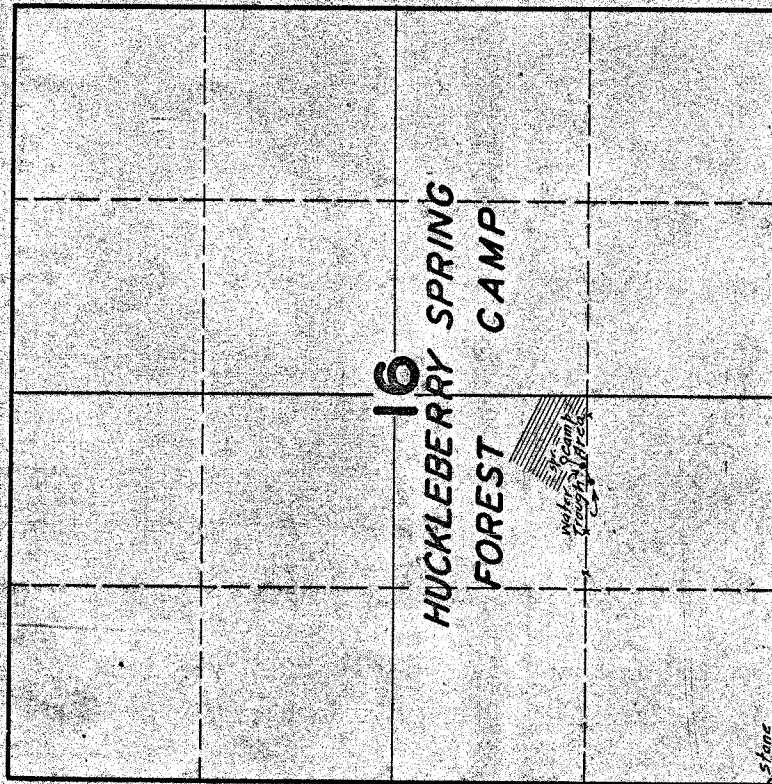

FINAL PROOF SURVEY

UNDER

Application No. 19547 Permit No. 15133

IN NAME OF

U.S. FOREST SERVICE - MALHEUR NATIONAL FOREST

Surveyed MAY 20 1947, by JAS. E. DUNNELL

Pin 15133
16681