


T. 15. R. 9W. W.M.

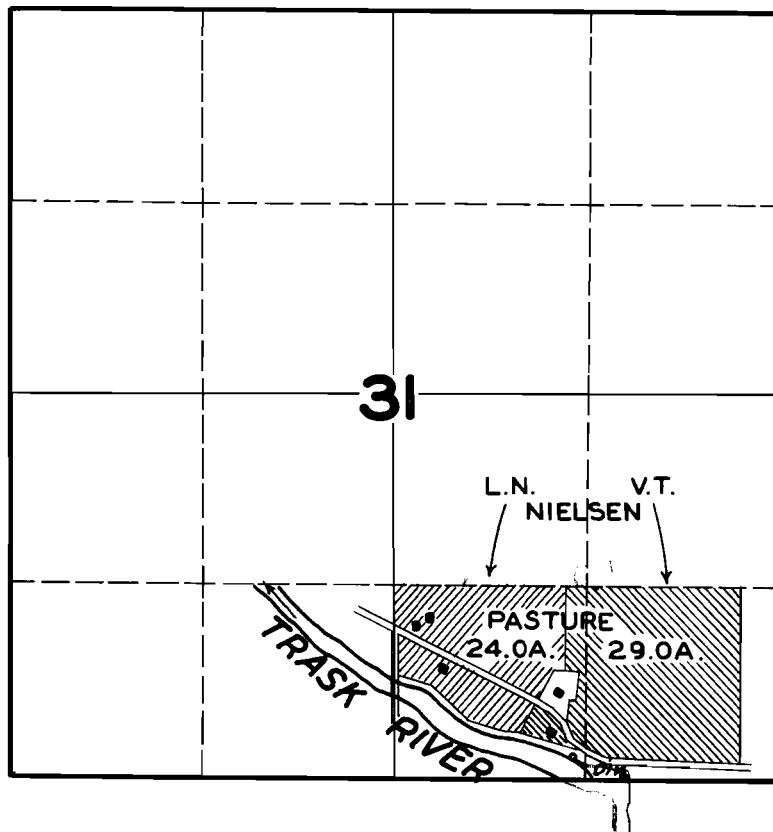

FINAL PROOF SURVEY
UNDER

Application No. **19599** ... Permit No. **15186** ...
IN NAME OF

MRS. MARIE NIELSEN ESTATE

Surveyed **SEP. 13, 1948**, by **JAS. E. BUNNELL**