


**T.8S.R.39E.W.M.**

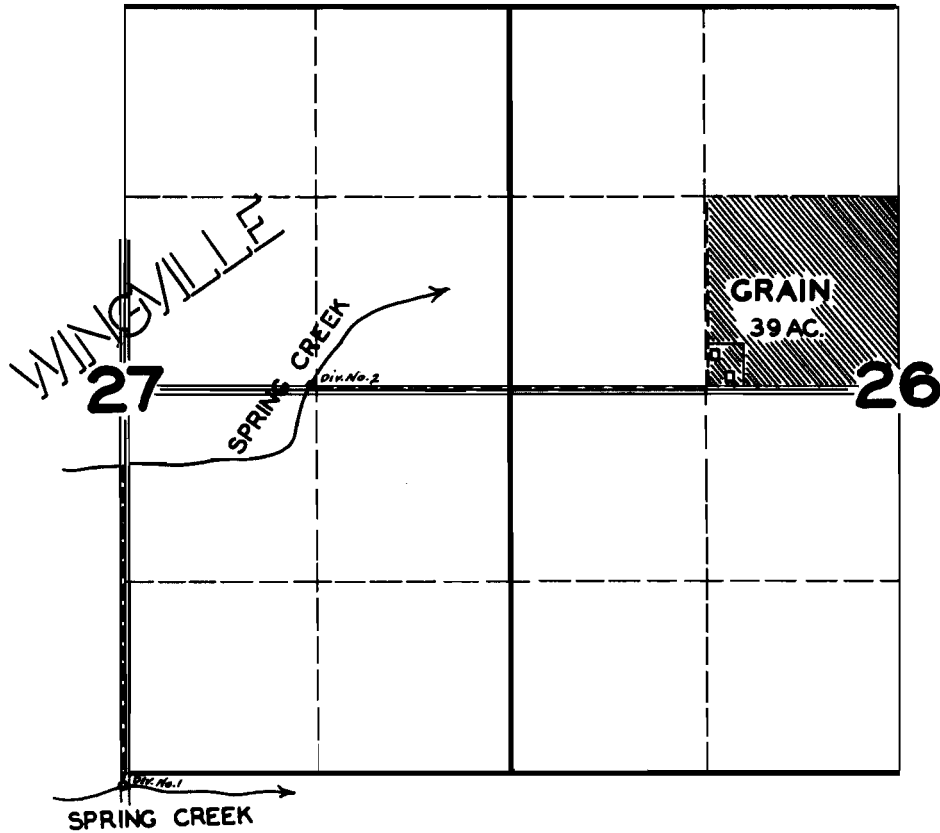

**FINAL PROOF SURVEY**

**UNDER**


**Application No. 19653 Permit No. 15236**

**IN NAME OF**

**L.A. & ANNA PEARL SIEG**

**Surveyed JULY 3 1946, by *J. Russell***

**T.8S.R.39E.W.M.**

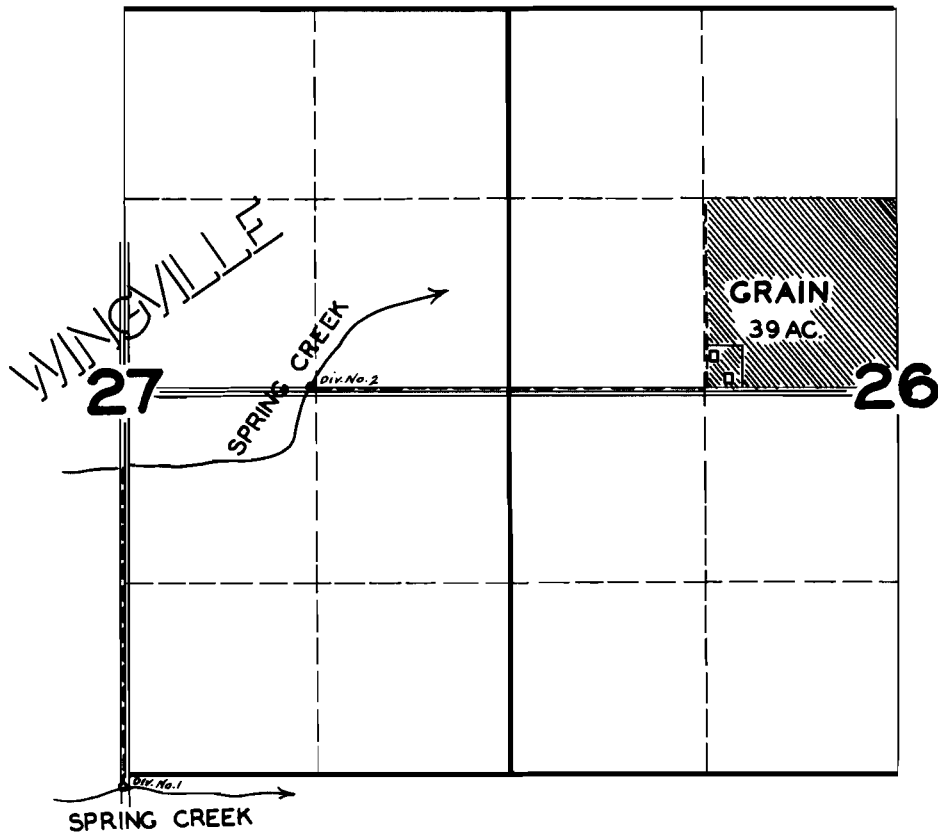

**FINAL PROOF SURVEY**

UNDER

Application No. 19653 Permit No. 15236

IN NAME OF

L.A. & ANNA PEARL SIEG

Surveyed JULY 3 1946 by James Russell