


T.13S.R.1E.W.M.

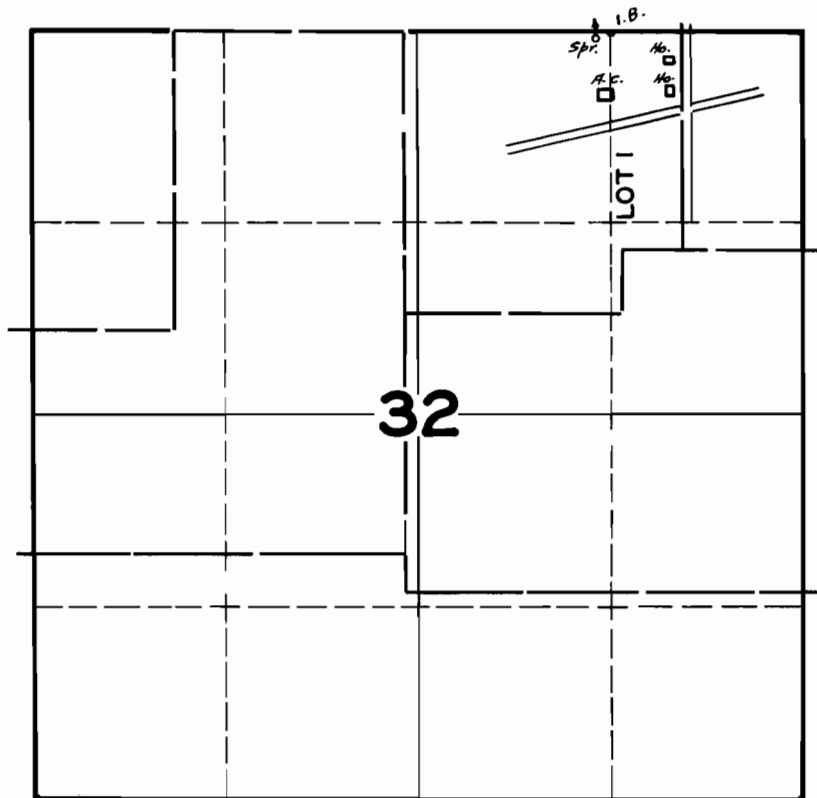

**FINAL PROOF SURVEY
UNDER**

Application No. 19689 Permit No. 15268

IN NAME OF

D. L. COCHRAN

Surveyed MAY 7, 1947, by JAS. E. BUNNELL