


T.4S. R.10W.W.M.

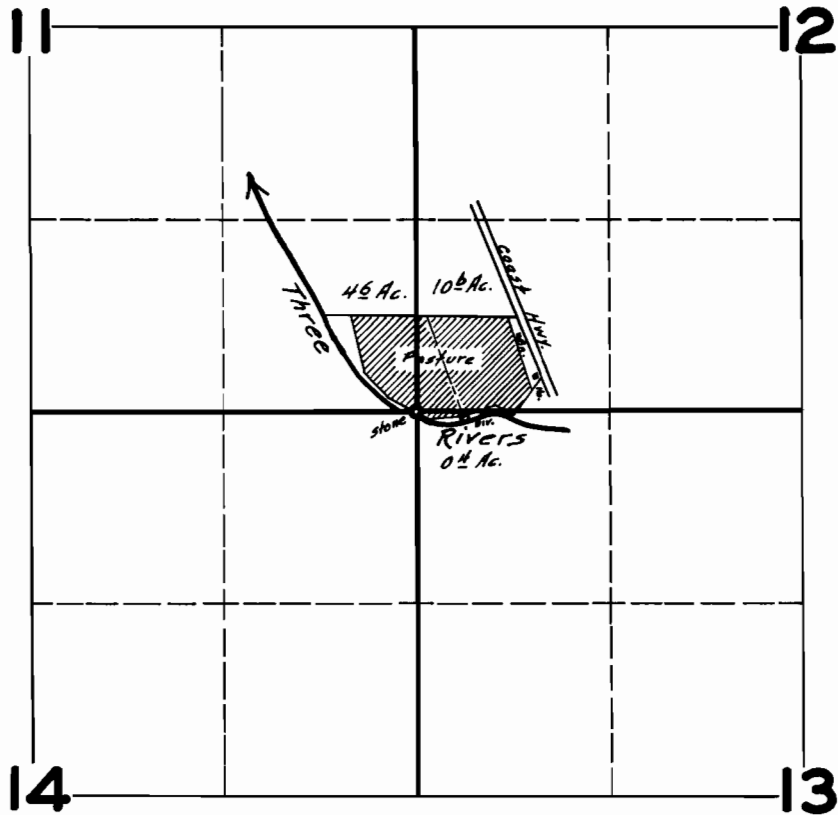

**FINAL PROOF SURVEY**  
UNDER

Application No. 19692 Permit No. 15271

IN NAME OF

WALLACE DUVAL

Surveyed JUNE 18 1945, by *[Signature]*