


T.5N.R.35E.W.M.

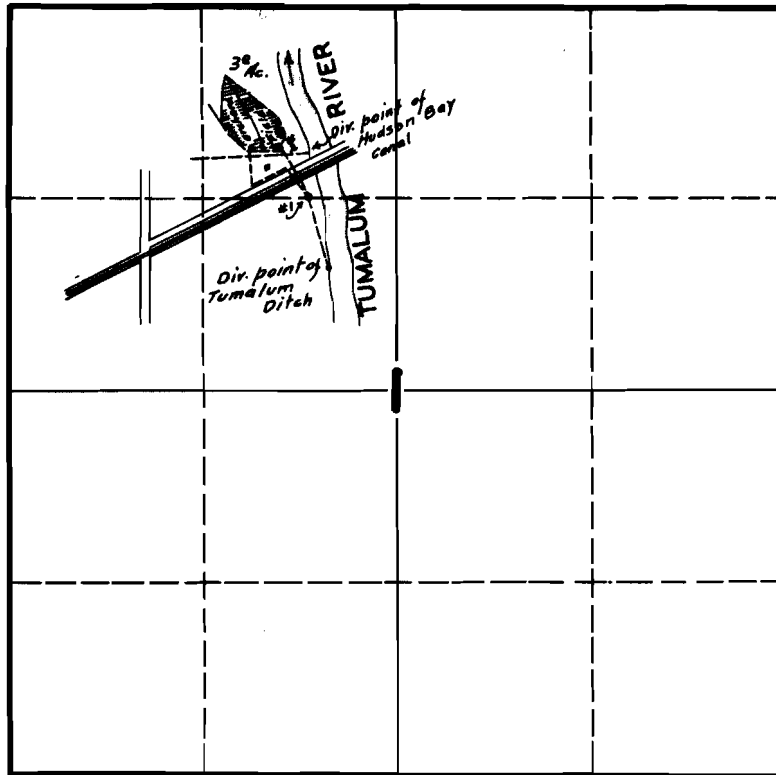

**FINAL PROOF SURVEY
UNDER**

Application No. 19701 Permit No. 15279

IN NAME OF

MRS. FRANK PHELPS

Surveyed APR. 19 1946, by JAS. E. BUNNELL