


T.7S.R.1W.W.M.

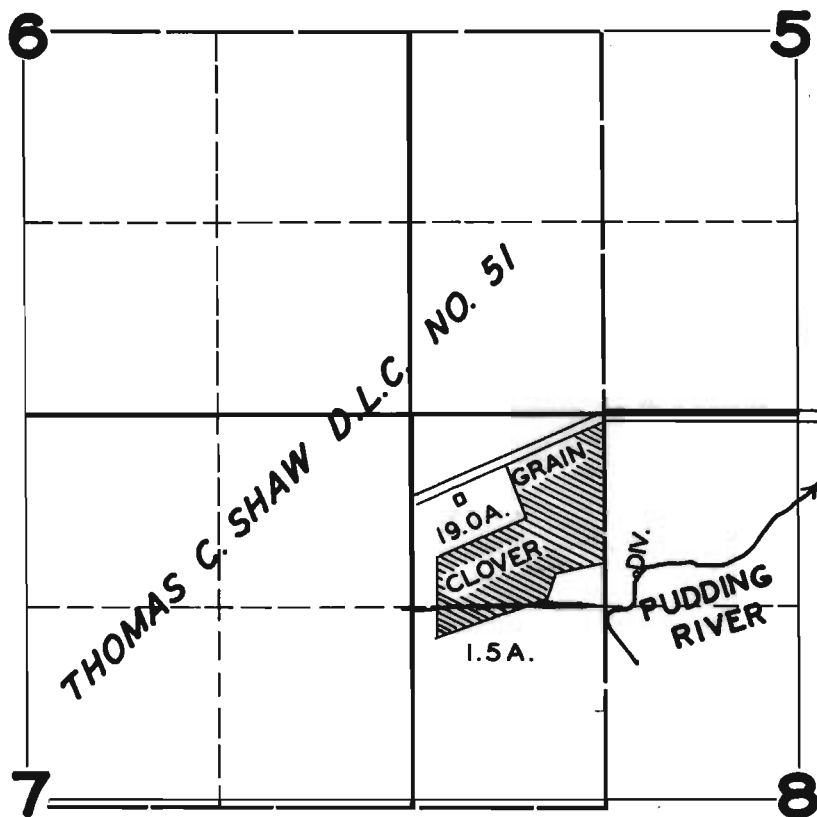

FINAL PROOF SURVEY UNDER

Application No. 19773 Permit No. 15356

IN NAME OF

REUBEN EGGIMAN

Surveyed JUN. 16 1947, by JAS. E. BUNNELL