


T. IS. R. 2 W. W. M.

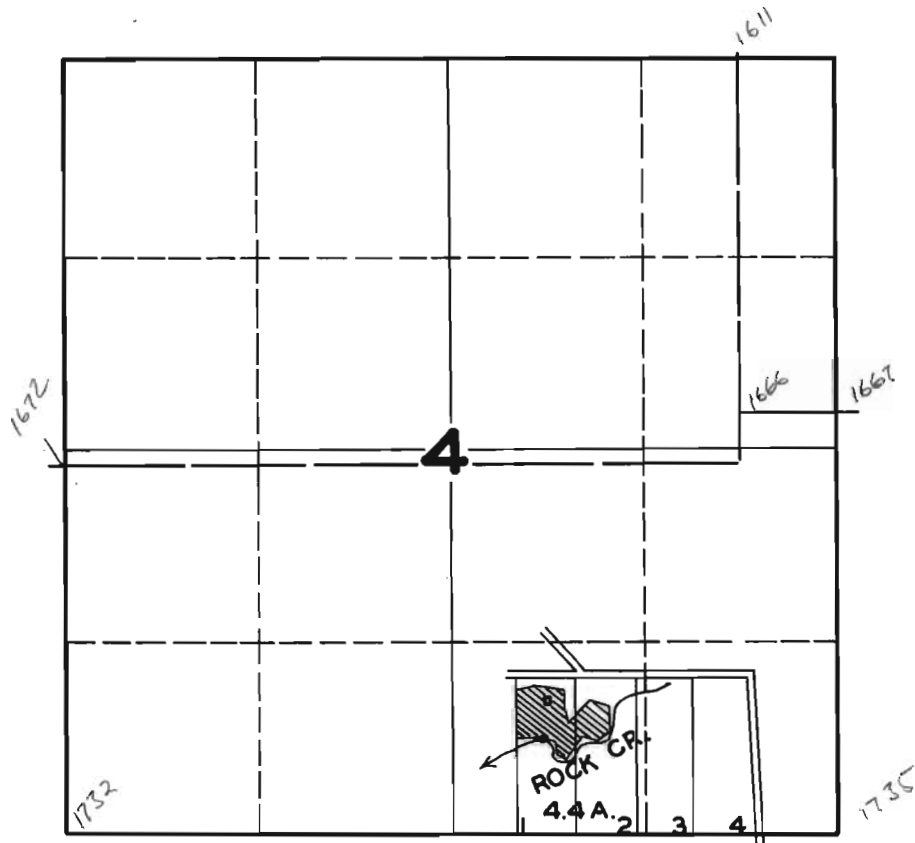

FINAL PROOF SURVEY UNDER

Application No. **19782** Permit No. **15364**
IN NAME OF

J. P. K. JENSEN

Surveyed **JUL. 31**, 1947, by **JAS. E. BUNNELL**