


T.18S.R.11W.W.M.

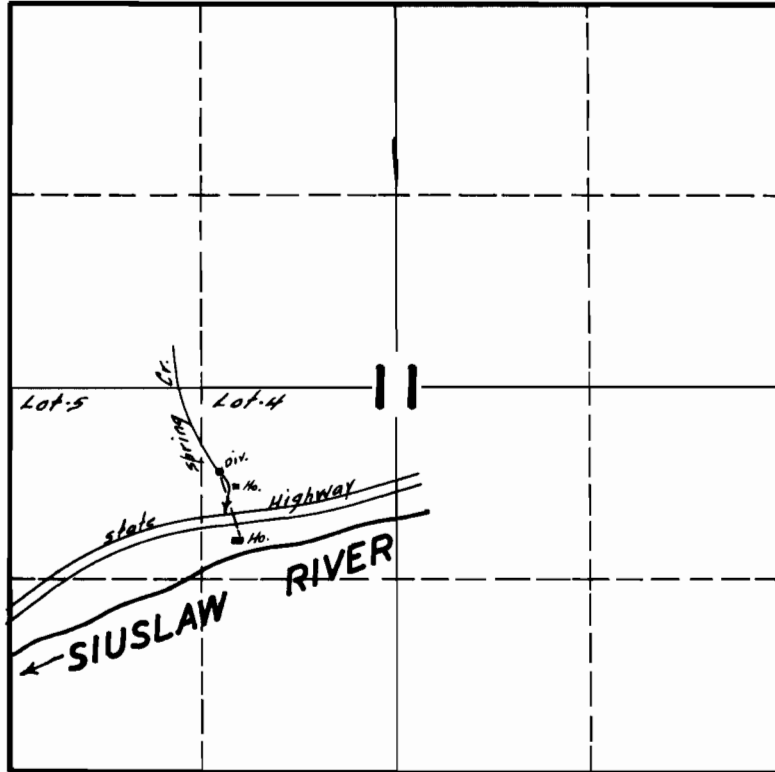

FINAL PROOF SURVEY UNDER

Application No. 19815 Permit No. 15394

IN NAME OF

RALPH WOLF

Surveyed AUG. 7, 1946, by John J. Russell