


**T.8S.R.39E.W.M.**

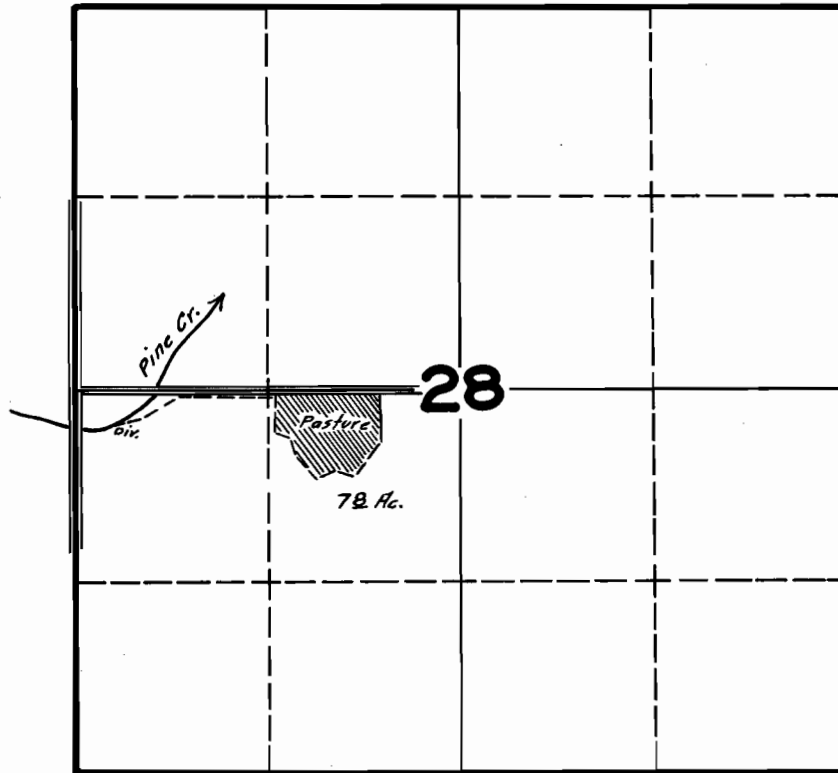

**FINAL PROOF SURVEY  
UNDER**

**Application No. 19847 Permit No. 15428**

**IN NAME OF**

**GEORGE W. ERICKSON**

**Surveyed JULY 5, 1946, by**

*James C. Hummel*