


# T.8S.R.3W.W.M.

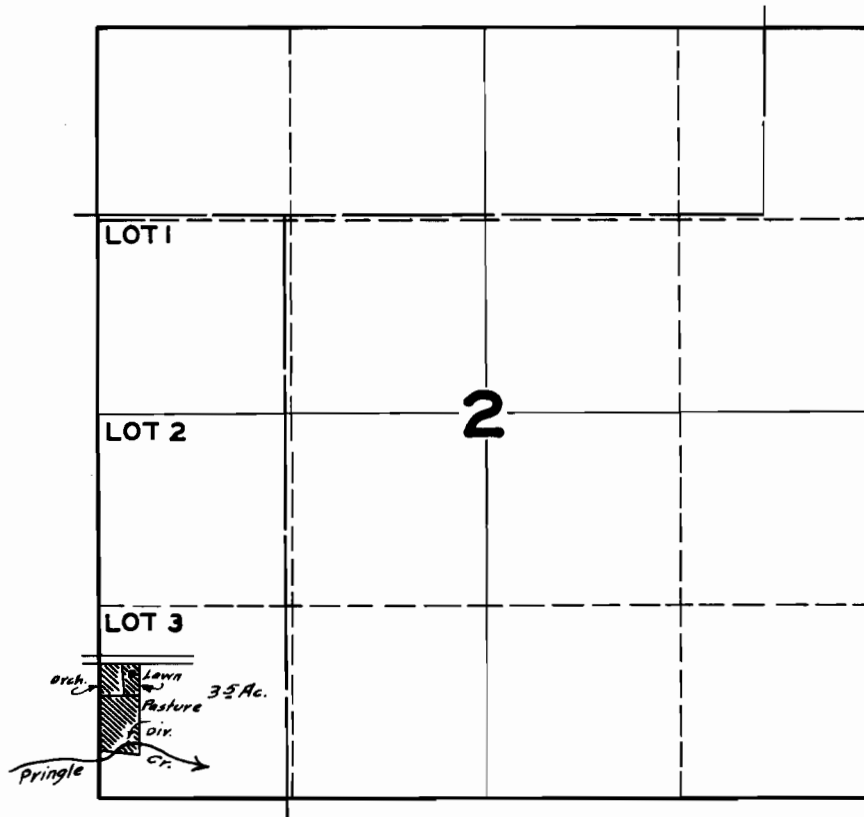

## FINAL PROOF SURVEY UNDER

Application No. 19863 Permit No. 15440

IN NAME OF

R.M. FITZMAURICE

Surveyed AUG. 14 1947, by JAS. E. BUNNELL