


T. 12 S. R. 3 W. W.M.

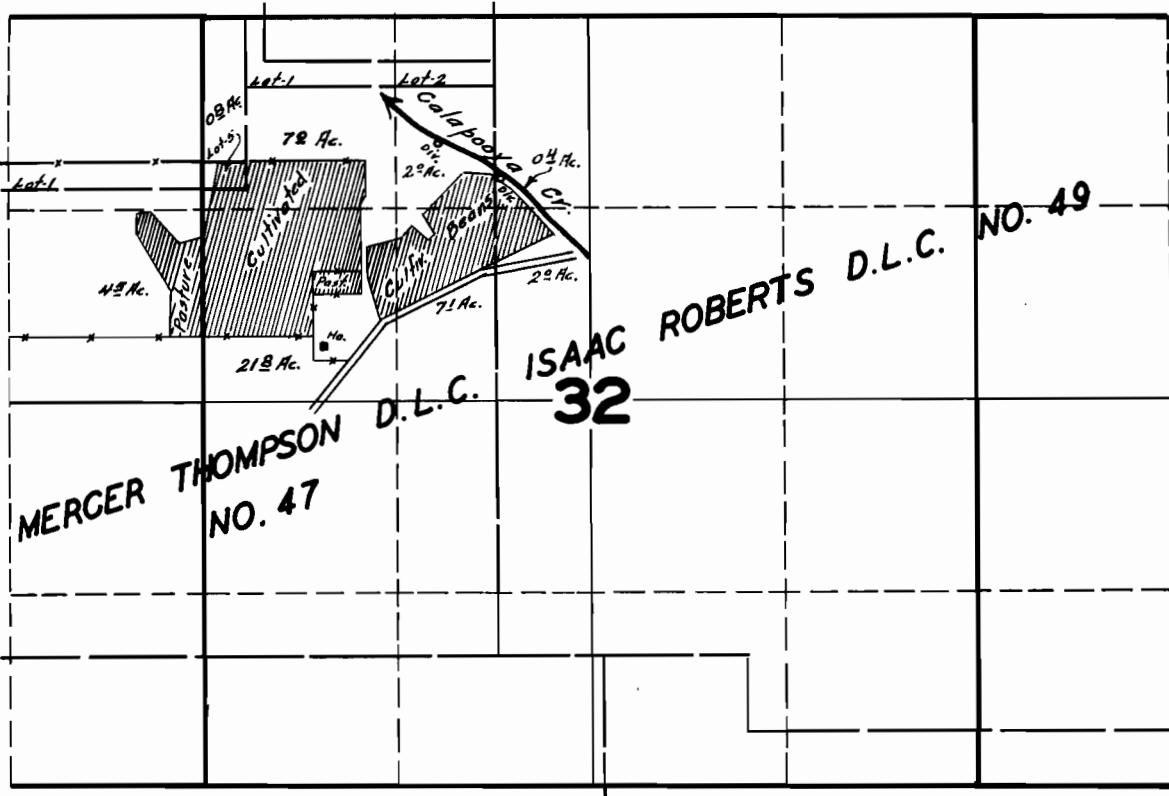

FINAL PROOF SURVEY

UNDER

Application No. 19905 Permit No. 15482

IN NAME OF

ARTHUR M. HAWKINS

Surveyed MAY 8 1946 by [Signature]