


T. 6 S. R. 1 W. W. M.

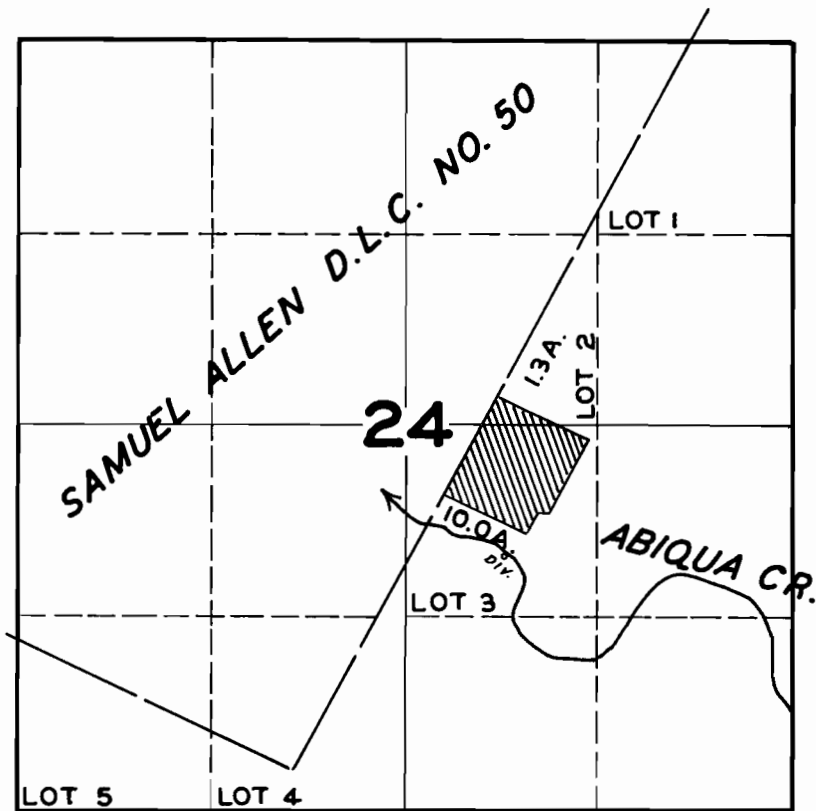

FINAL PROOF SURVEY UNDER

Application No. 19909 Permit No. 15485
IN NAME OF

CLARA SCHNIDER

Surveyed APR. 18 1949, by JAS. E. BUNNELL