


T.3S. R.3W.W.M.

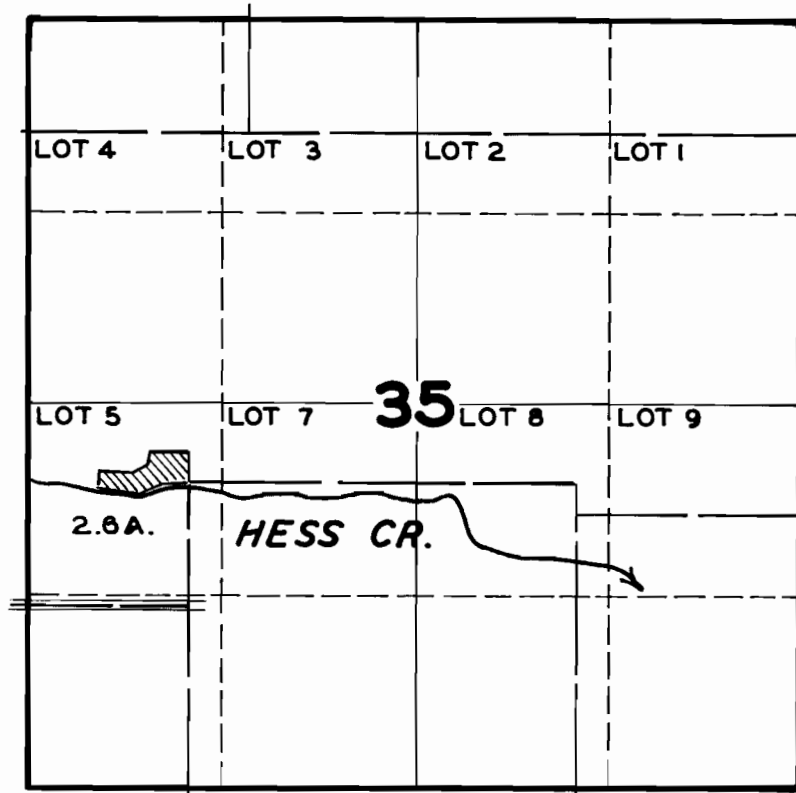

FINAL PROOF SURVEY

UNDER

Application No. **19932**... Permit No. **15506**...

IN NAME OF

OTTO F. JOHNSON

Surveyed **MAY 7** 1949, by **JAS. E. BUNNELL**