


T. 20S. R. 3W. W.M.

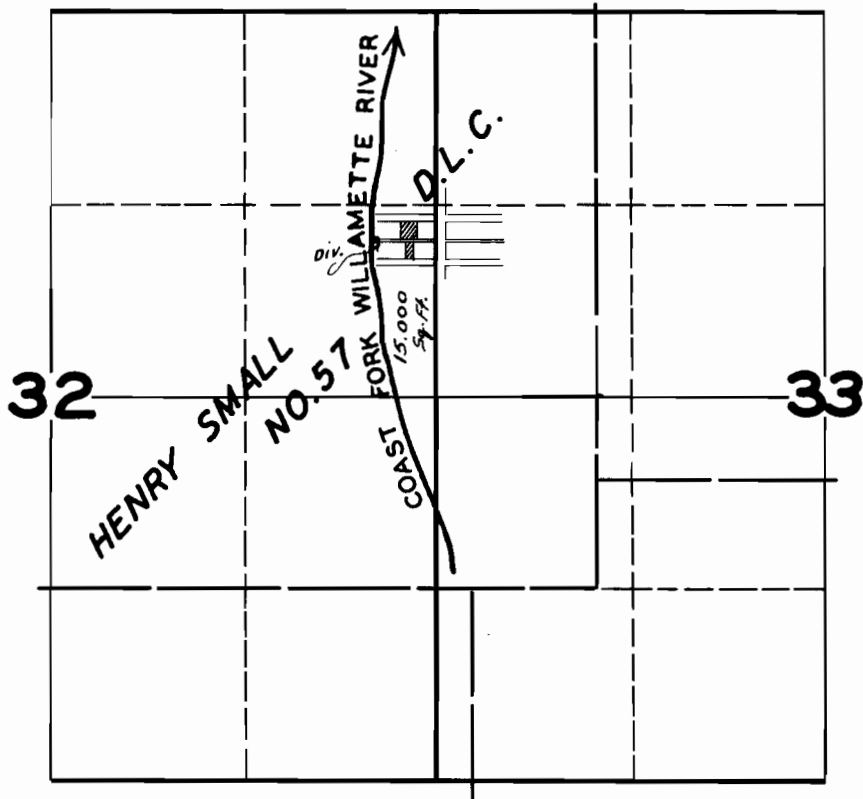

FINAL PROOF SURVEY

UNDER

Application No. 19913 Permit No. 15522

IN NAME OF

L.E. SPANGENBERG & CLARA E. SPANGENBERG

Surveyed AUG. 6 1947, by JAS. E. BUNNELL