


# T. 7S. R. 1W. W. M.

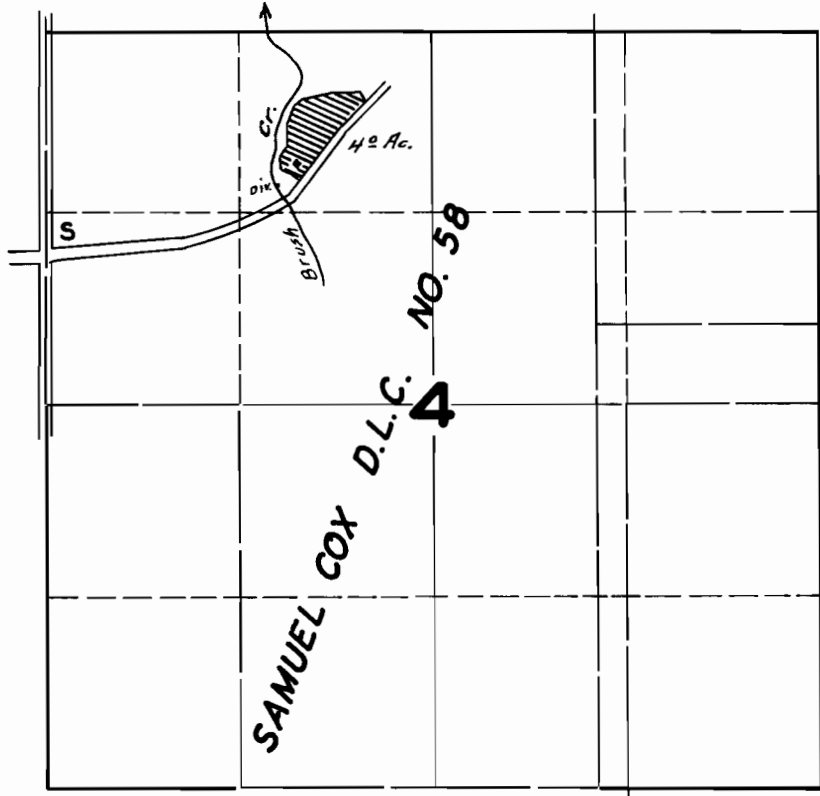

## FINAL PROOF SURVEY UNDER

Application No. 19958 Permit No. 15529

IN NAME OF

JOHN LARSON

Surveyed AUG. 4, 1947, by JAS. E. BUNNELL