


T.7S.R.3W.W.M.

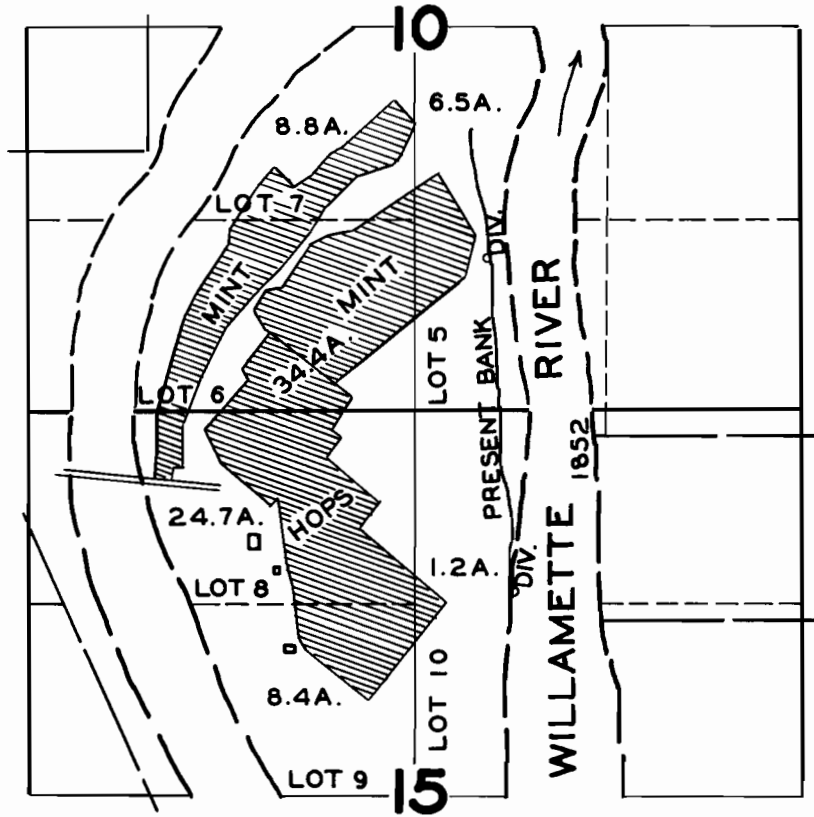

FINAL PROOF SURVEY UNDER

Application No. **19968** Permit No. **15538**

IN NAME OF

A.W. CROCKER

Surveyed **MAR. 18 1947**, by **JAS. E. BUNNELL**